


T.4 S.R.3 W.W.M.

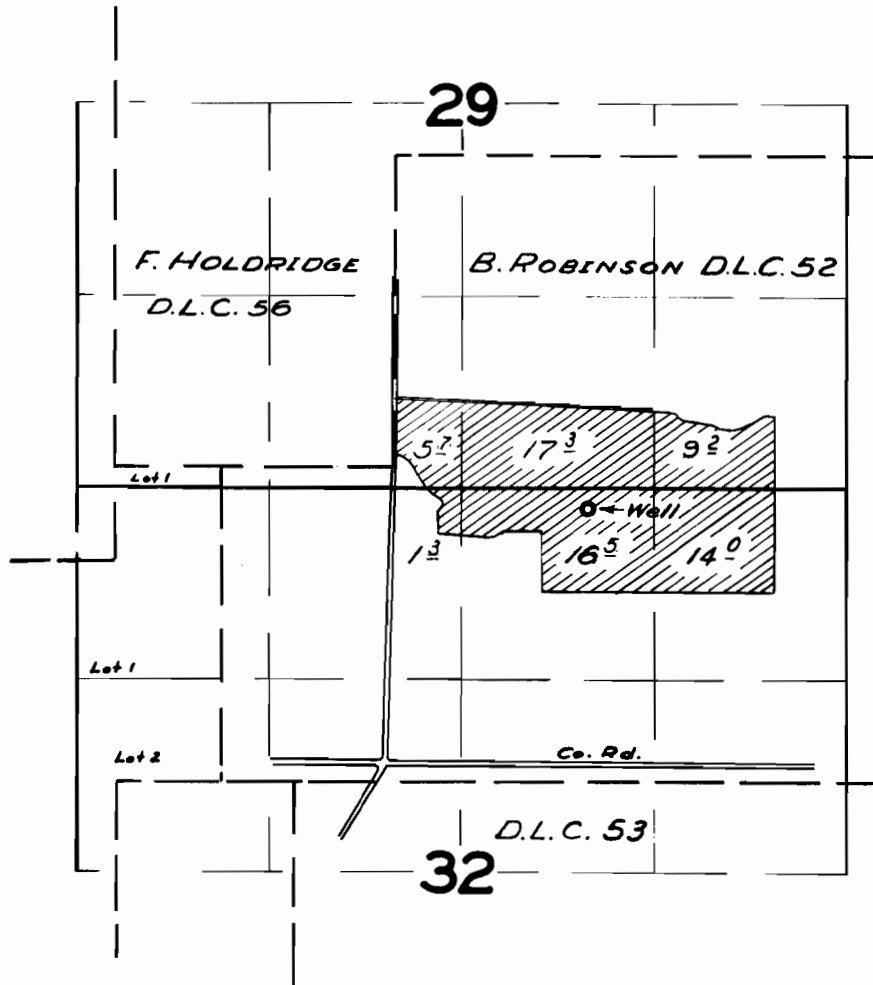

**FINAL PROOF SURVEY**  
UNDER

Application No. G-602 Permit No. G-504  
IN NAME OF

JESSE M. HOCKEMA

Surveyed 24 MAY 1960, by M. B. Bish