


T.4S.R.4W.WM

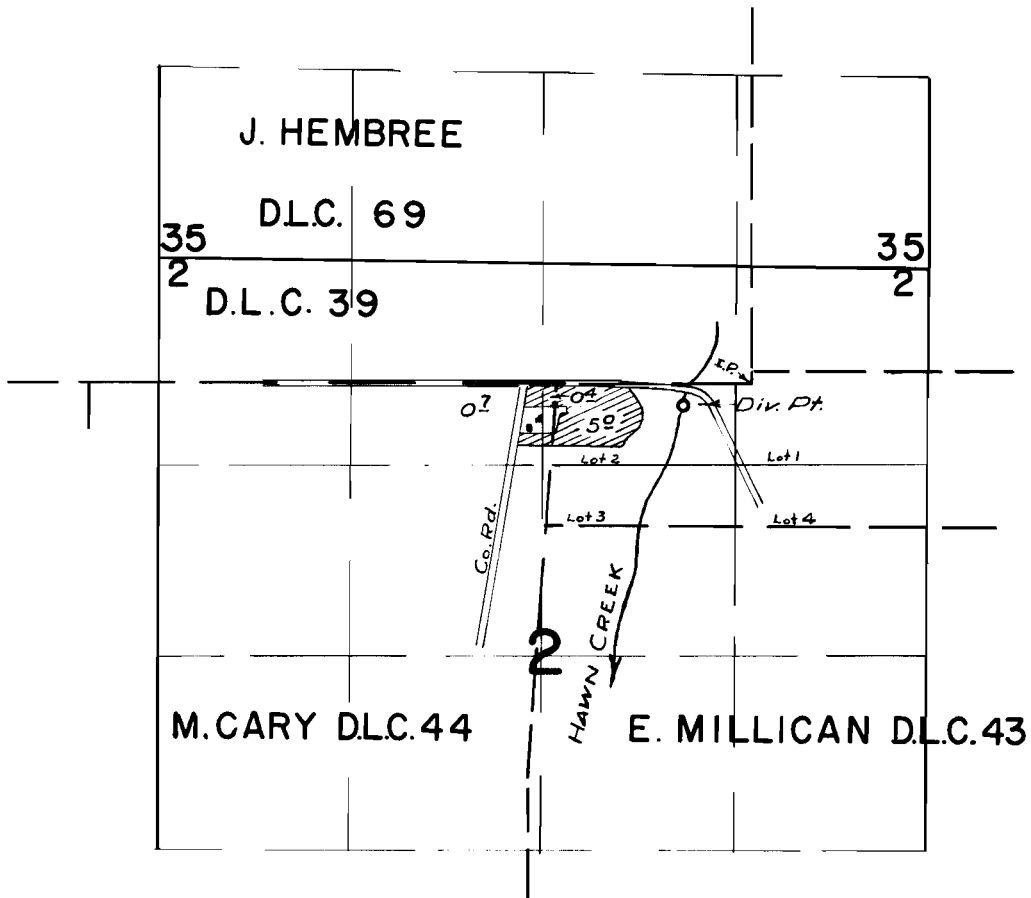

FINAL PROOF SURVEY UNDER

Application No. 29074 Permit No. 22865...
IN NAME OF

HAWN CREEK DIST. IMPROVEMENT CO....

23 MAY 60
Surveyed 1 MAY 1958, by *T. Bish*