


T. 17S. R. 7W. W.M.

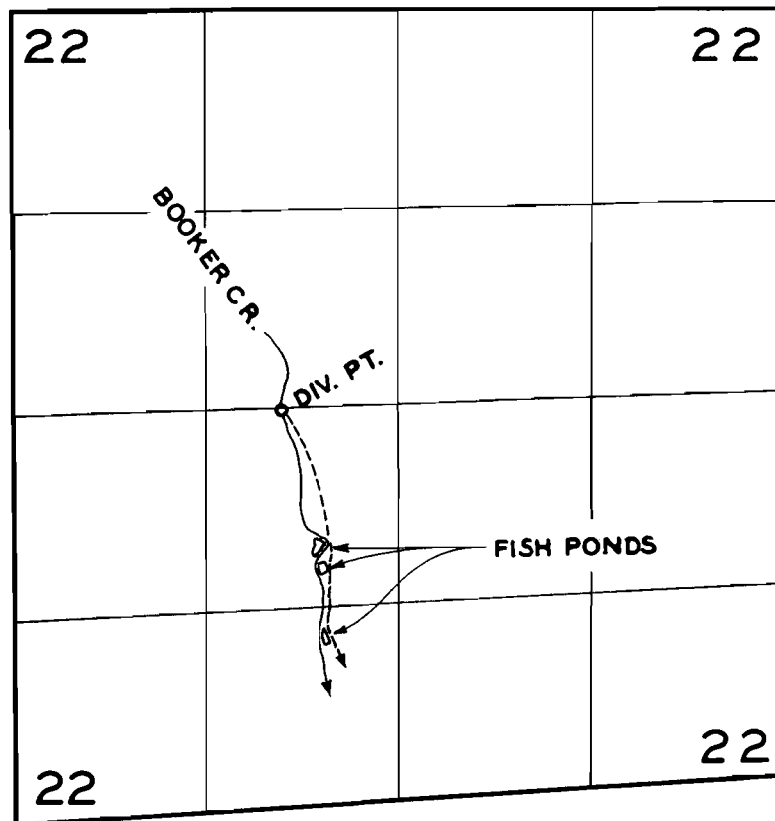

FINAL PROOF SURVEY
UNDER

R 31358
Application No. 31359 Permit No. 24704
IN NAME OF

LESTER LAKE

Surveyed MAY 3 1960, by C.O. BARTELS