


T.10S.R.39E.W.M.

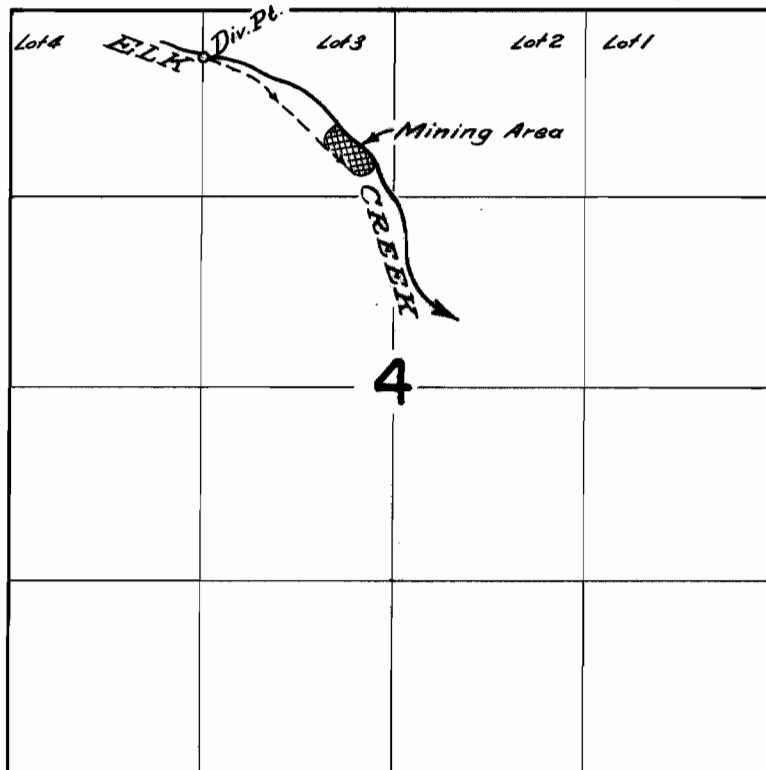

FINAL PROOF SURVEY
UNDER

Application No. 20865 Permit No. 16342
IN NAME OF

CLARK ALLEN

Surveyed Sept. 20 1960, by C.D. Baile