


POA
 T-6436
 V45 P168
 2,3528

T.5N.R.35E.W.M.

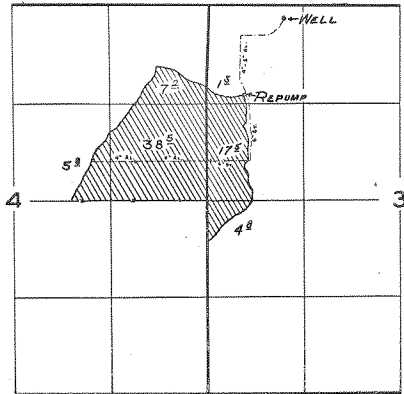

FINAL PROOF SURVEY
 UNDER

Application No. *21424*... Permit No. *41352*...
 IN NAME OF

GRANT YORK

Surveyed *July 13, 1960*, by *M.B. 154*.....