


T. 12 S. R. 40 E. W.M.

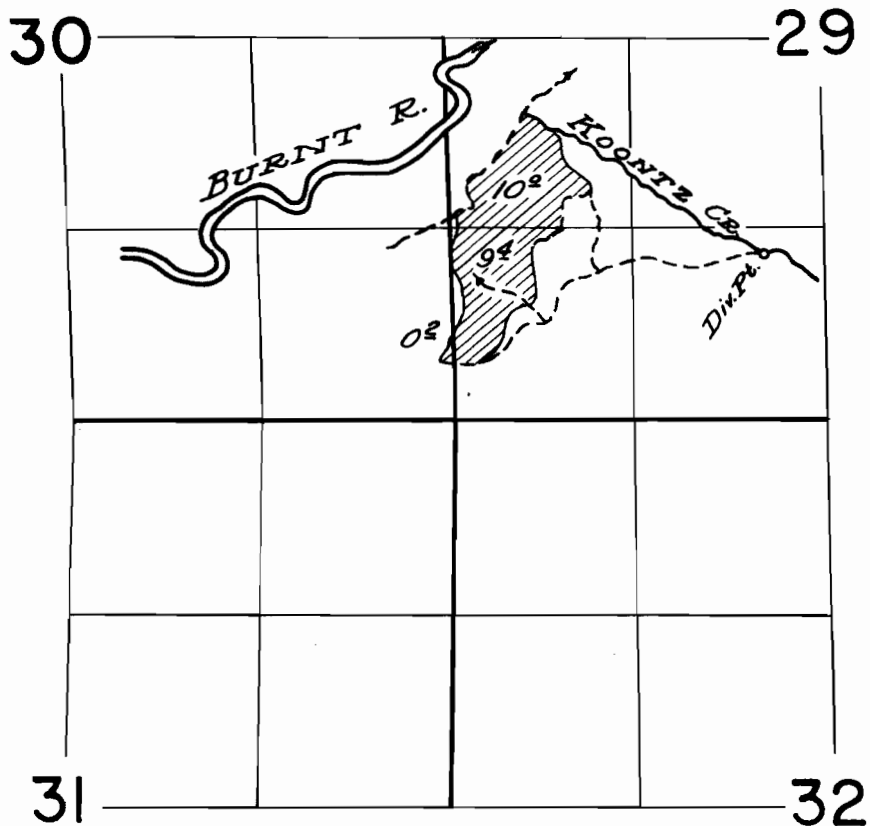

FINAL PROOF SURVEY
UNDER

Application No. 29802... Permit No. 23510...
IN NAME OF

.....*RACEY BROTHERS*.....

Surveyed *Sept. 17, 1960*, by *C.O. Baile*.....