


T. 12S. R. 5&6 W. W.M.

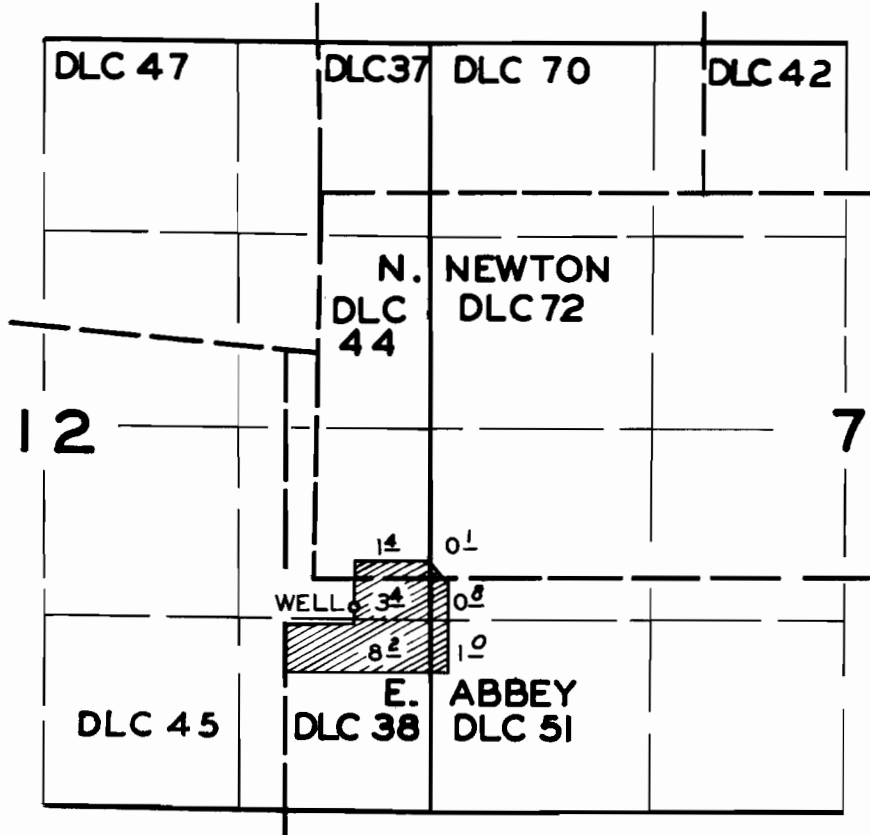

FINAL PROOF SURVEY
UNDER

Application No. G408 Permit No. G282
IN NAME OF

BENTON COUNTY SCHOOL DISTRICT NO. 17-C

Surveyed JULY 28 1960, by *R. H. Jackson*