


T. 10S. R. 6W. W.M.

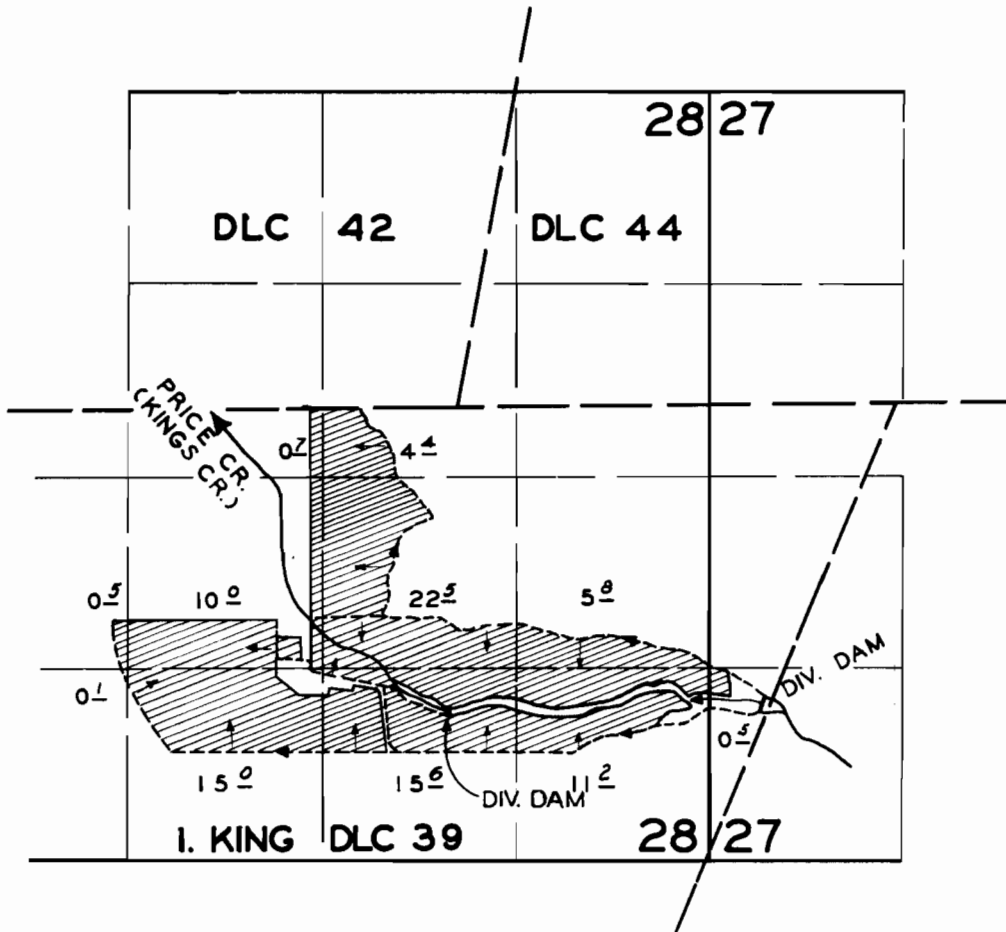

FINAL PROOF SURVEY  
UNDER

Application No. 23561 Permit No. 18868  
IN NAME OF

CHESTER WM. CHAMBERS

Surveyed JULY 29 1960, by