


T. 12S. R. 6W. W.M.

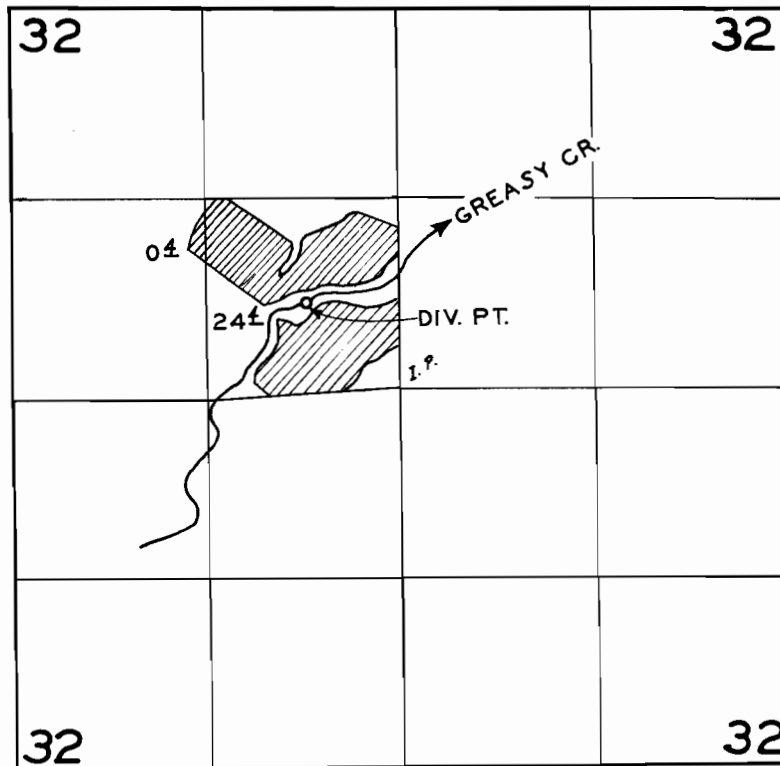

FINAL PROOF SURVEY
UNDER

Application No. 28743 Permit No. 22615
IN NAME OF

ARTHUR L. PETERSON

Surveyed JULY 27 1960, by

Handwritten signature