


T.14S.R.5W.W.M.

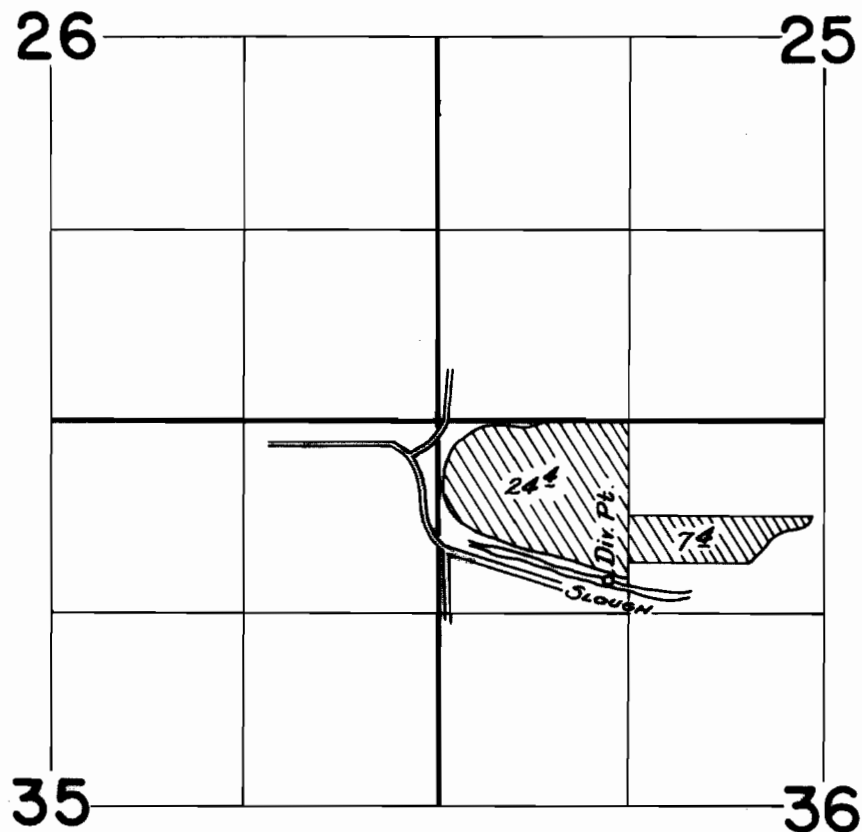

FINAL PROOF SURVEY
UNDER

Application No. 29314.... Permit No. 23085....
IN NAME OF

.....JESSE HARPER.....

Surveyed Oct. 19, 1960, by C. D. Bastida....