


T. 12S. R. 5W. W.M.

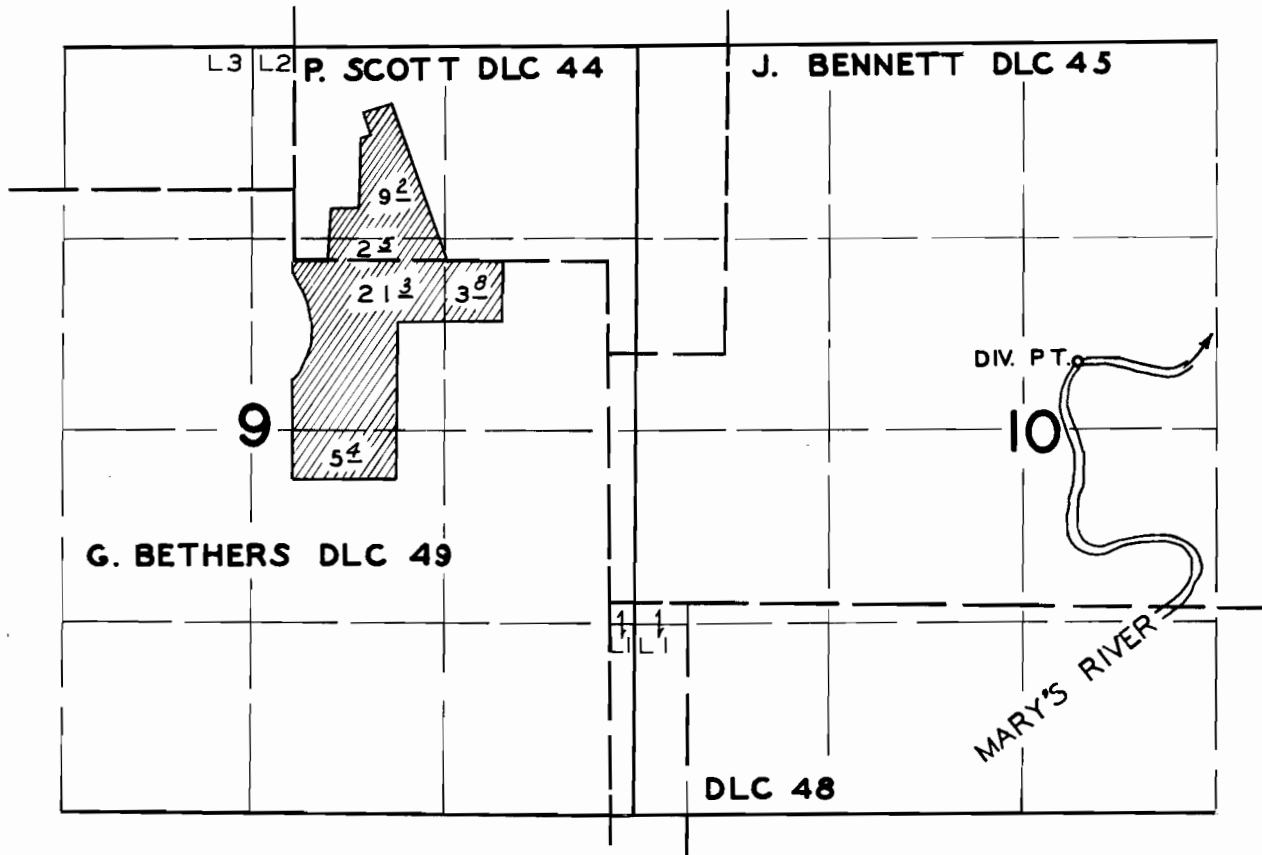

FINAL PROOF SURVEY  
UNDER

Application No. 30451 Permit No. 23988  
IN NAME OF

CORVALLIS COUNTRY CLUB

Surveyed JULY 28 1960, by

*A. Jackson*