


T.3S.R.4E.W.M.

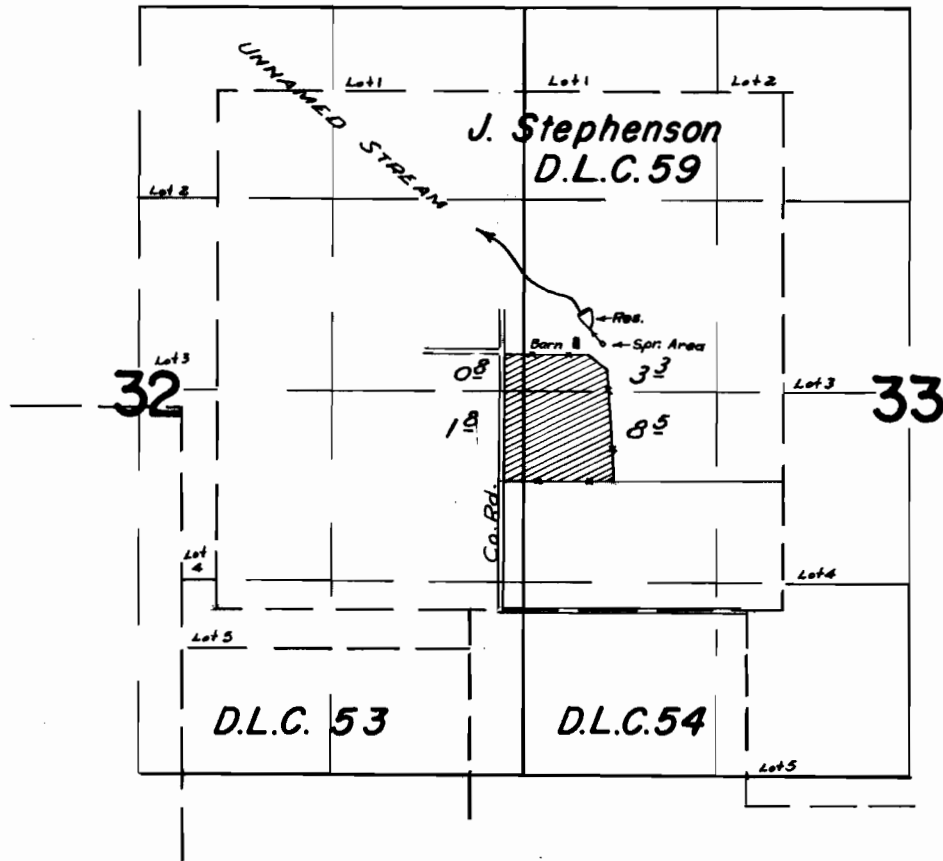

FINAL PROOF SURVEY UNDER

Application No. 31100 Permit No. 24512
R-31099 IN NAME OF R-1941

Surveyed 26 Aug. 1960, by M. B. Bish