


T.3S.R.4E.W.M.

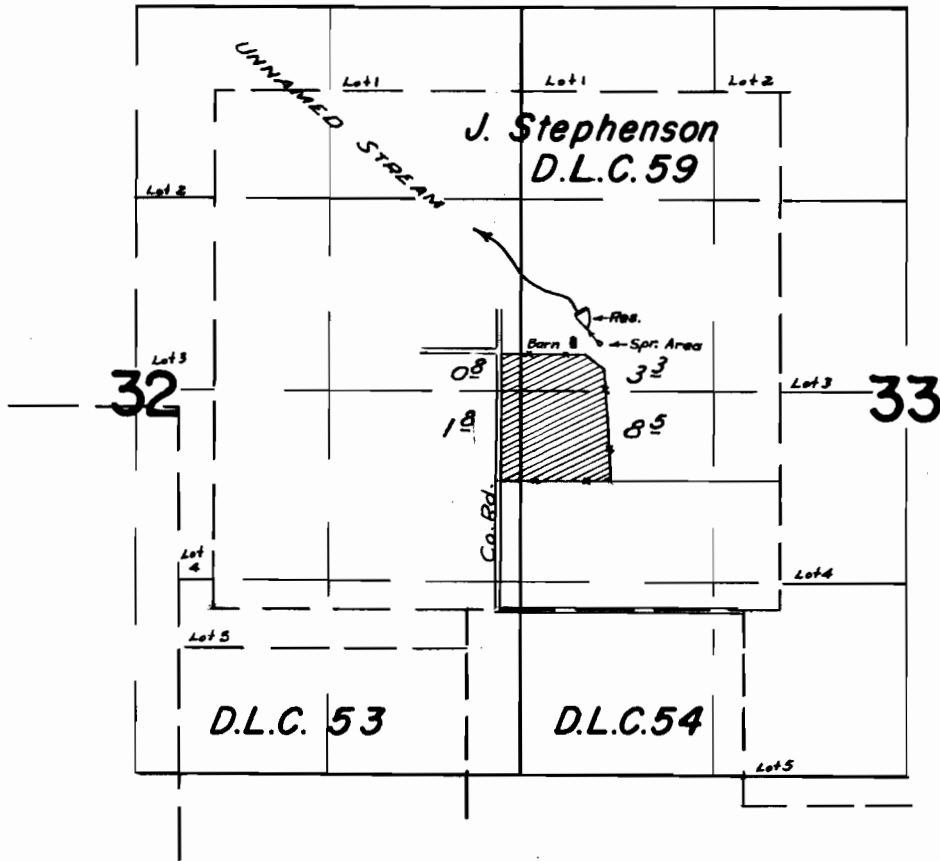

FINAL PROOF SURVEY UNDER

Application No. 31100 24512
R-31099 Permit No. R-1941
IN NAME OF

Surveyed 26 Aug. 1960, by M. B. Bish