


T. 2S. R. 4E.W.M.

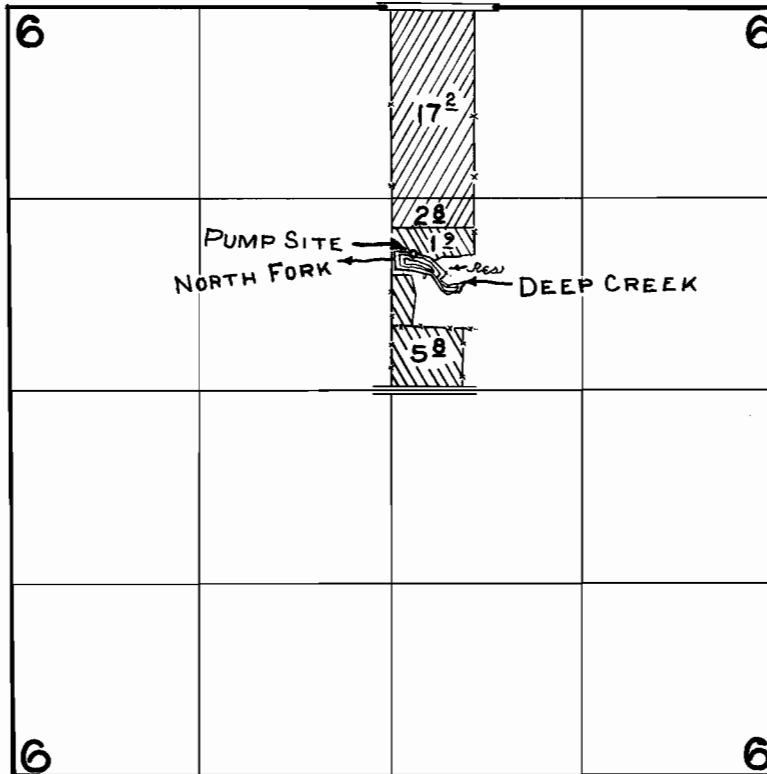

FINAL PROOF SURVEY

UNDER



SUPPLEMENTAL PRIMARY



R-31562 R-2021  
Application No. 31563 Permit No. 24906  
IN NAME OF

JAMES C. HIGGINBOTHAM

Surveyed Aug 22, 1960, by M. BISH