


T.26S. R.12W.W.M.

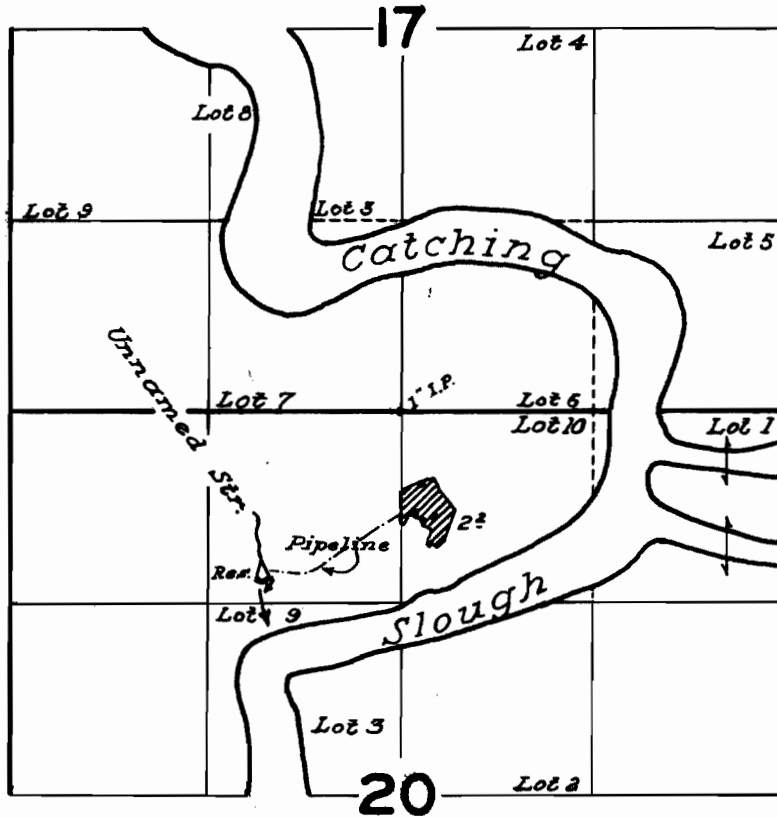

FINAL PROOF SURVEY
UNDER

Application No. ^{R-29877} 29969 Permit No. ^{R-1738} 23353
IN NAME OF

ESTELLE MILLER

Surveyed June 14, 1960, by *R. Jackson*