


T.26S. R.12W.W.M.

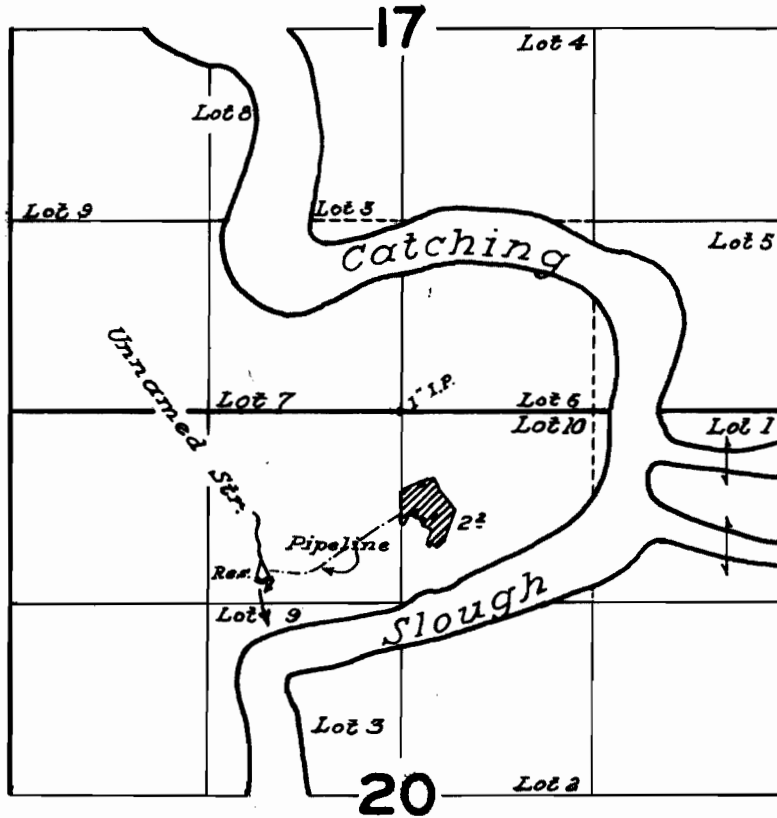

**FINAL PROOF SURVEY**  
UNDER

Application No. <sup>R-29877</sup> 29969 Permit No. <sup>R-1738</sup> 23353  
IN NAME OF

**ESTELLE MILLER**

Surveyed June 14, 1960, by *R. Jackson*