T. 28 S. R. 14 W.W.M.

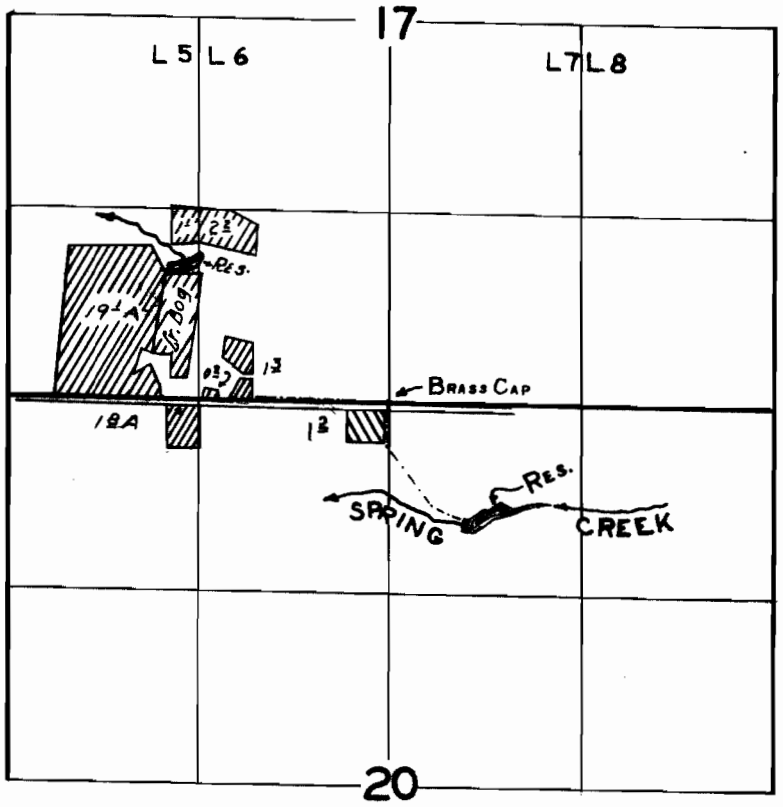

FINAL PROOF SURVEY

UNDER

SUPPLEMENTAL

PRIMARY

Application No. R-33076 33077 Permit No. R-2240 26157

IN NAME OF

W.W. Sherertz & R.J. Winters

Surveyed June 14 1960, by M. Bish

1960-C