


T.28S. R.14W.W.M.

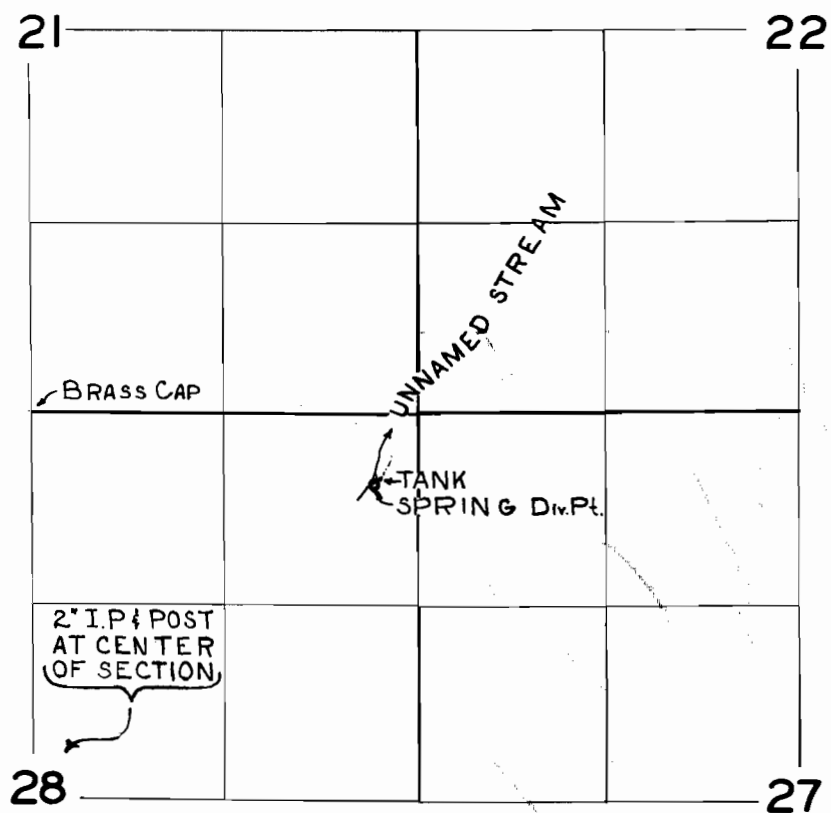

FINAL PROOF SURVEY UNDER

Application No. 33373.. Permit No. 26413....
IN NAME OF

.....GRAYDON HAGA.....

Surveyed JUNE 15 1960, by M. BISH.....