


T14S.R.15E.W.M.

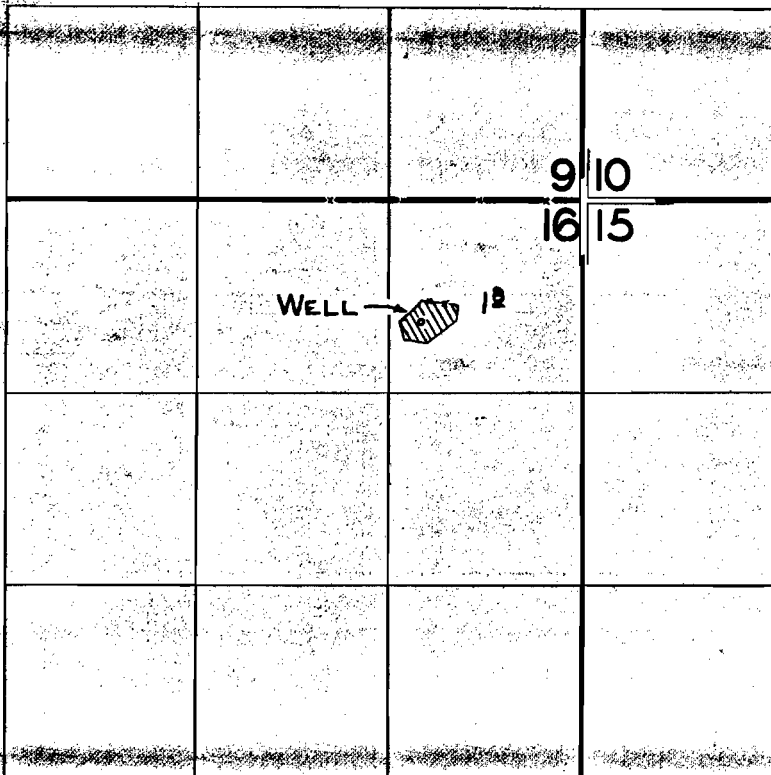

FINAL PROOF SURVEY UNDER

Application No. G-669... Permit No. G.590.....
IN NAME OF

RAYMOND ADKISSON

Surveyed Oct. 8... 1960., by M.BISH.....