


T.19S. R.20E.W.M.

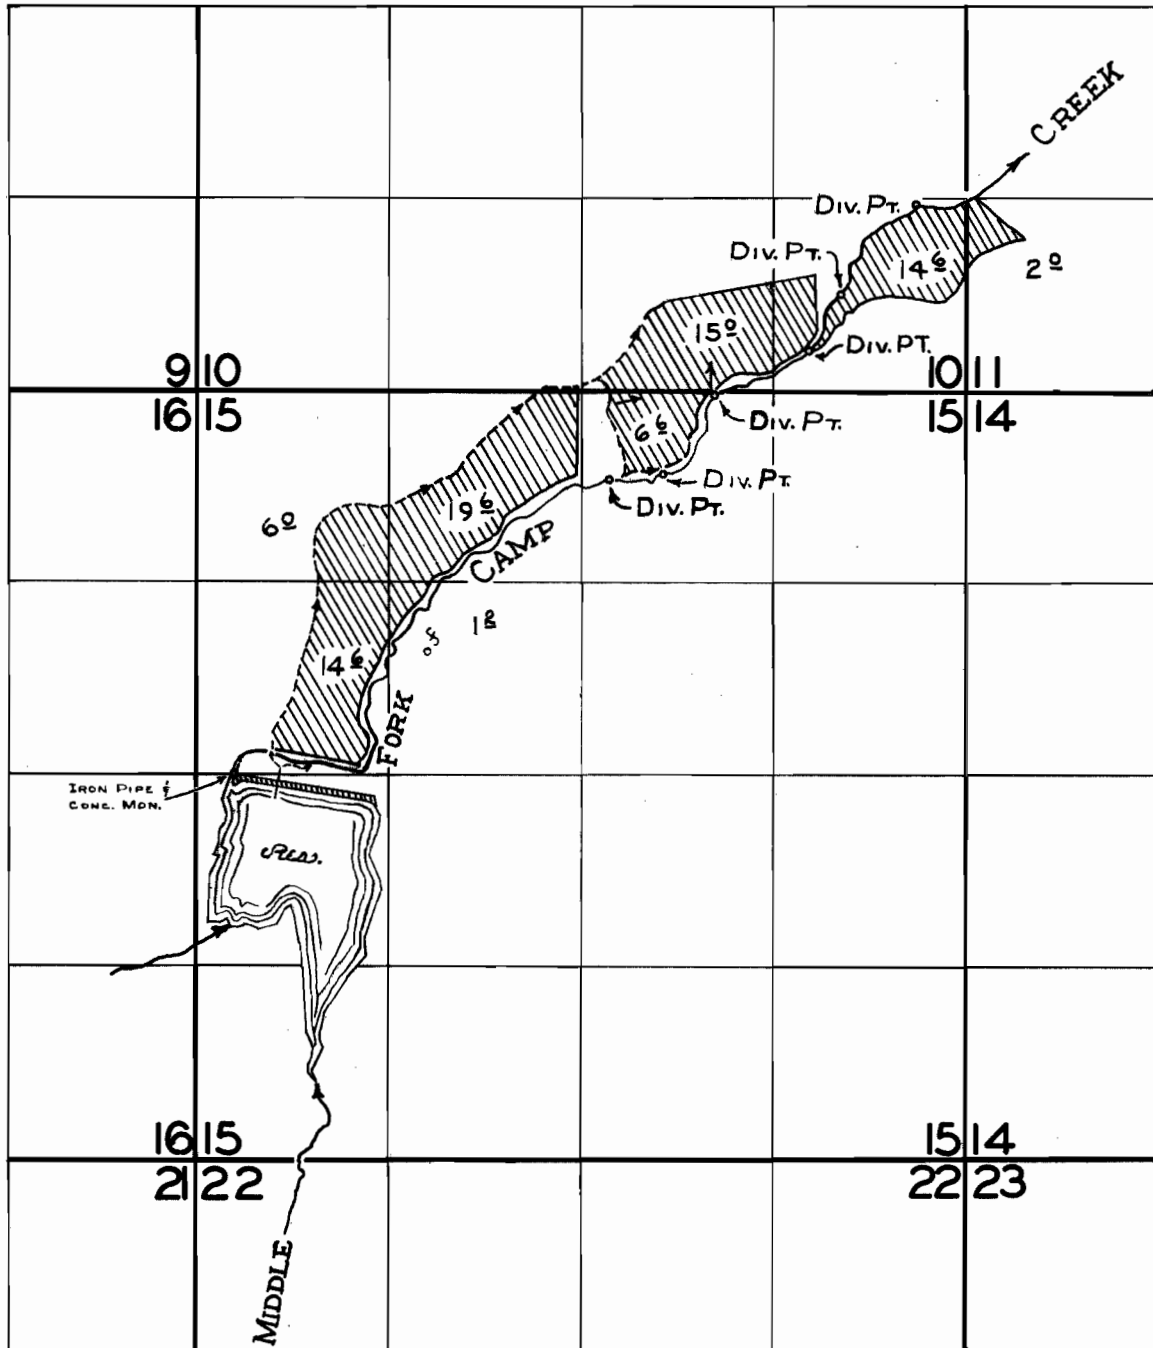

FINAL PROOF SURVEY
UNDER

R-25345 R-1102
Application No. 25346 Permit No. 19983
IN NAME OF

ROBERT T. GRISDALE & WIFE

Surveyed OCT 3 1960, by M. BISH