


T.19S. R.20E.W.M.

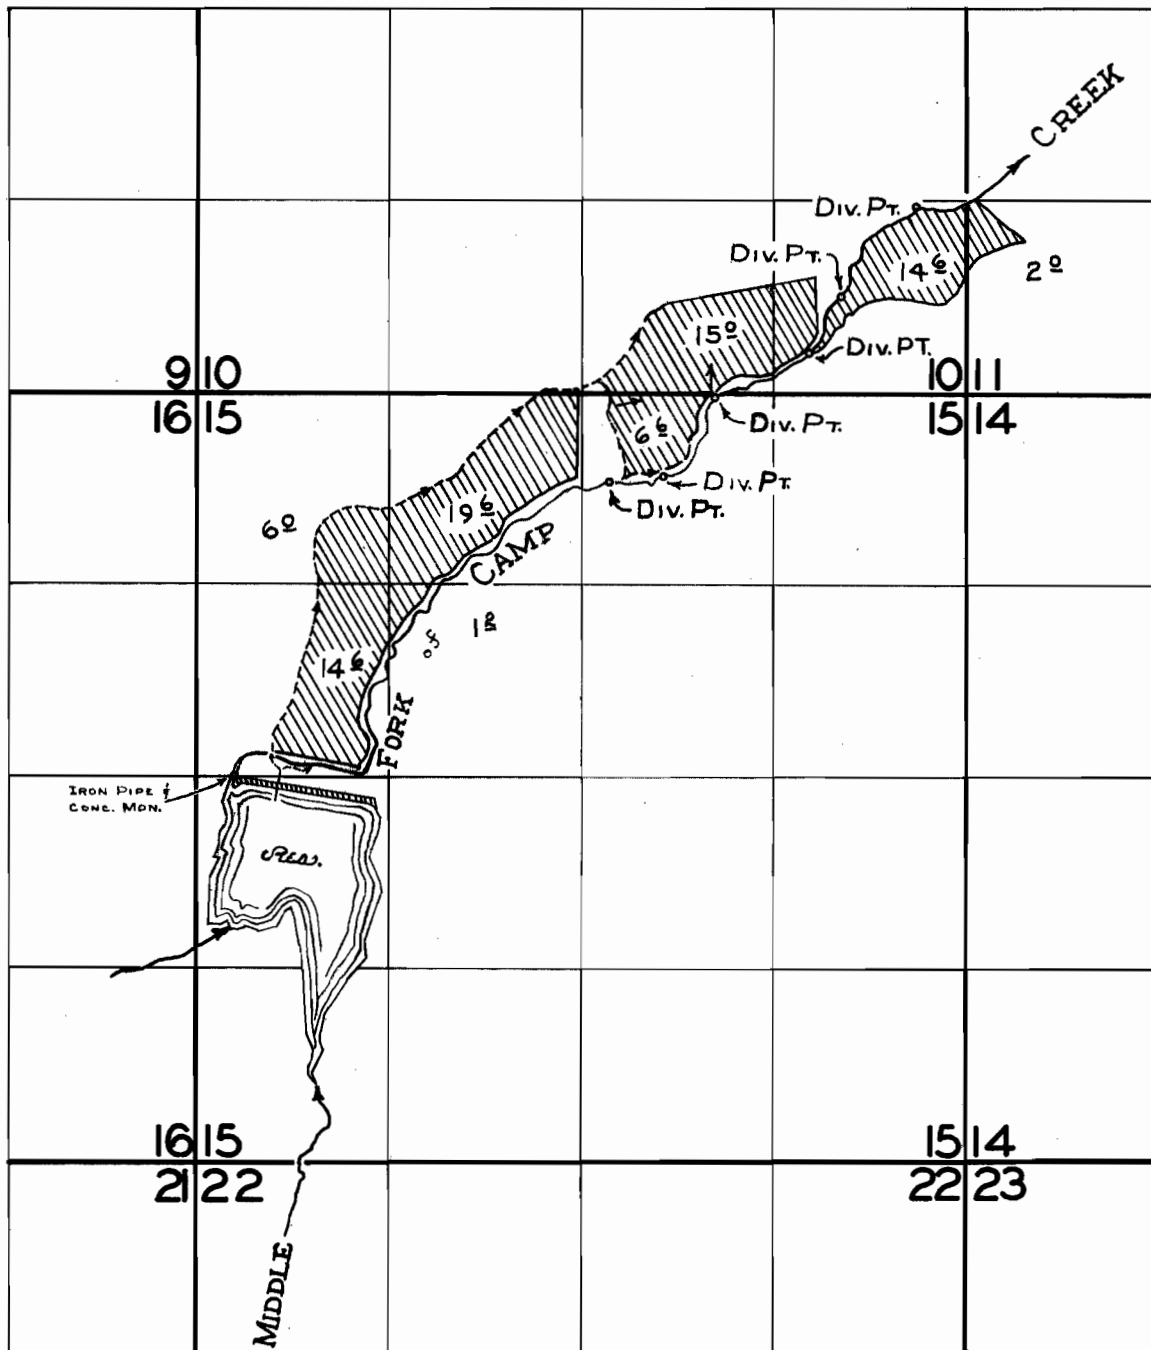

FINAL PROOF SURVEY
UNDER

Application No. R-25345 Permit No. R-1102
25346 IN NAME OF 19983

ROBERT T. GRISEDALE; WIFE

Surveyed OCT 3 1960, by M. BISH

1960-F
DCY-12 H 207