


T.32 S.R.5 W.W.M.

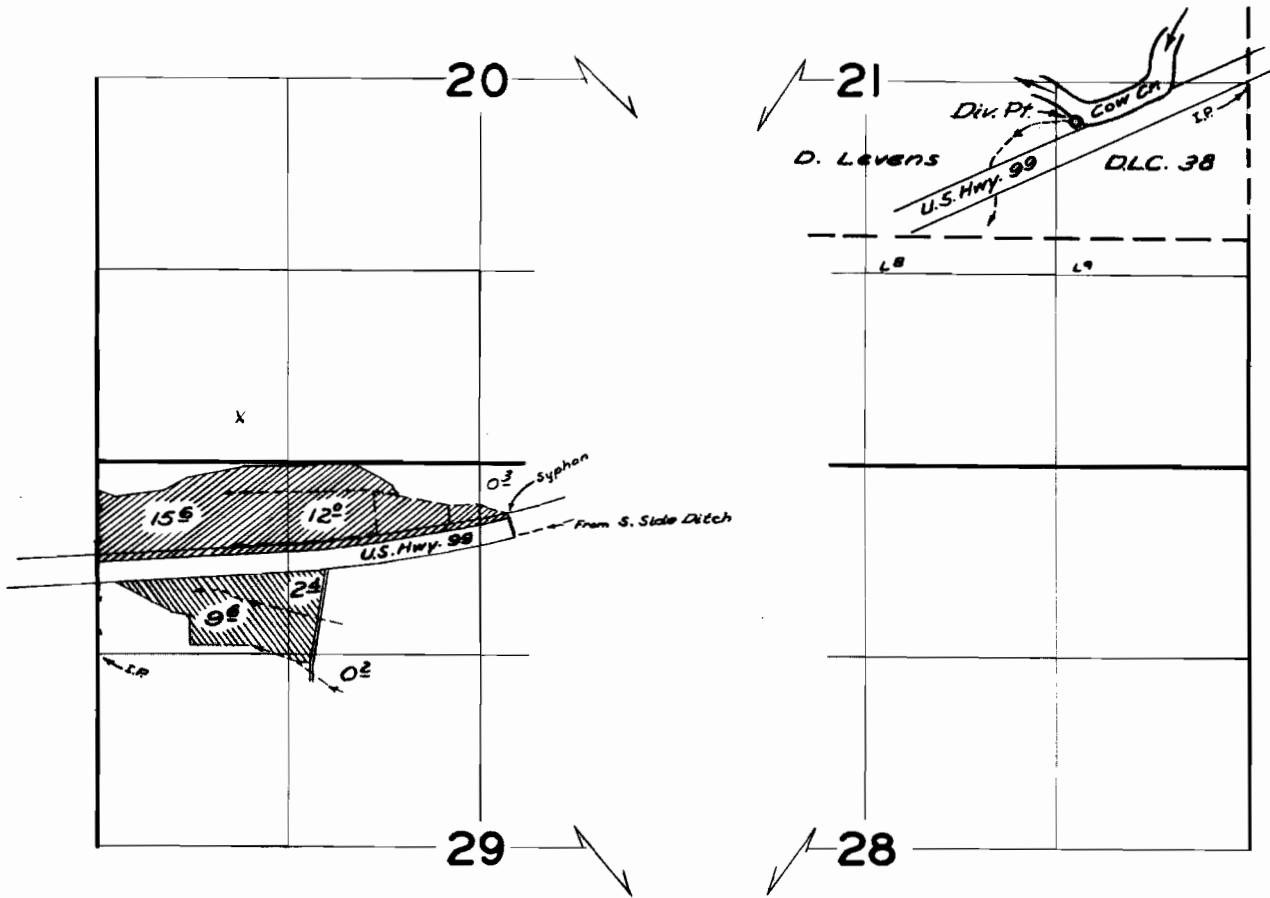

FINAL PROOF SURVEY UNDER

Application No. 28771 Permit No. 22623
 Application No. 28773 Permit No. 22624
 IN NAME OF

DAN F. CLARE

Surveyed 4 Sept. 1958, by M. Bish