


T. 27S. R. 6W. W.M.

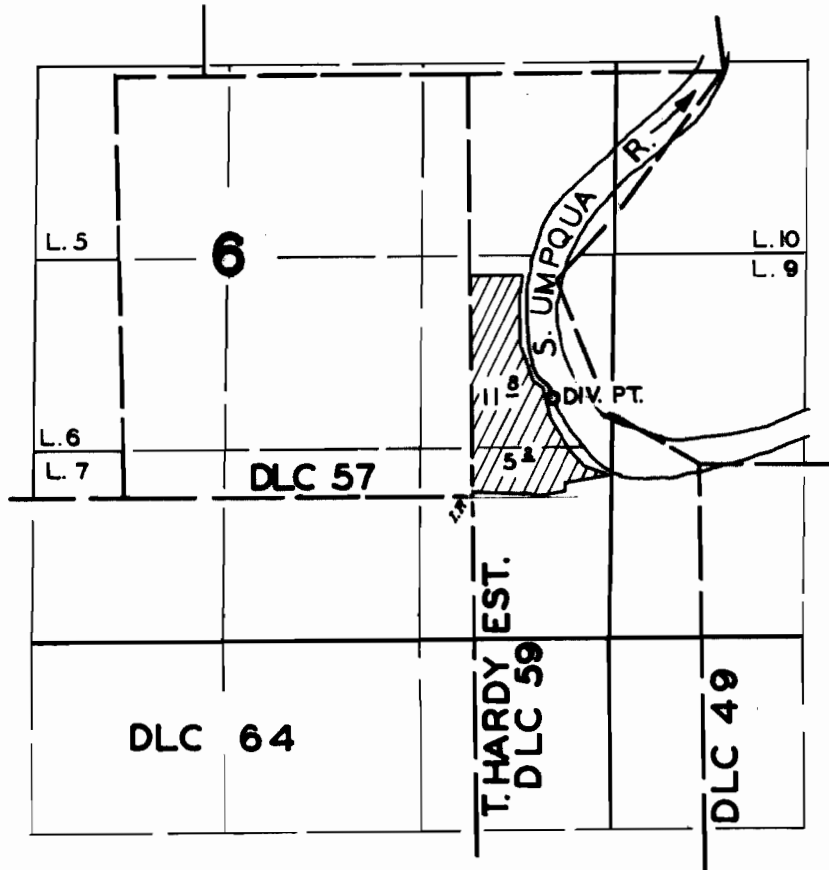

FINAL PROOF SURVEY
UNDER

Application No. 29674 Permit No. 23368
IN NAME OF

HENRY W. SCOTT

Surveyed AUG. 29. 1960. by C. O. BARTELS