


T. 28S. R. 6W. W.M.

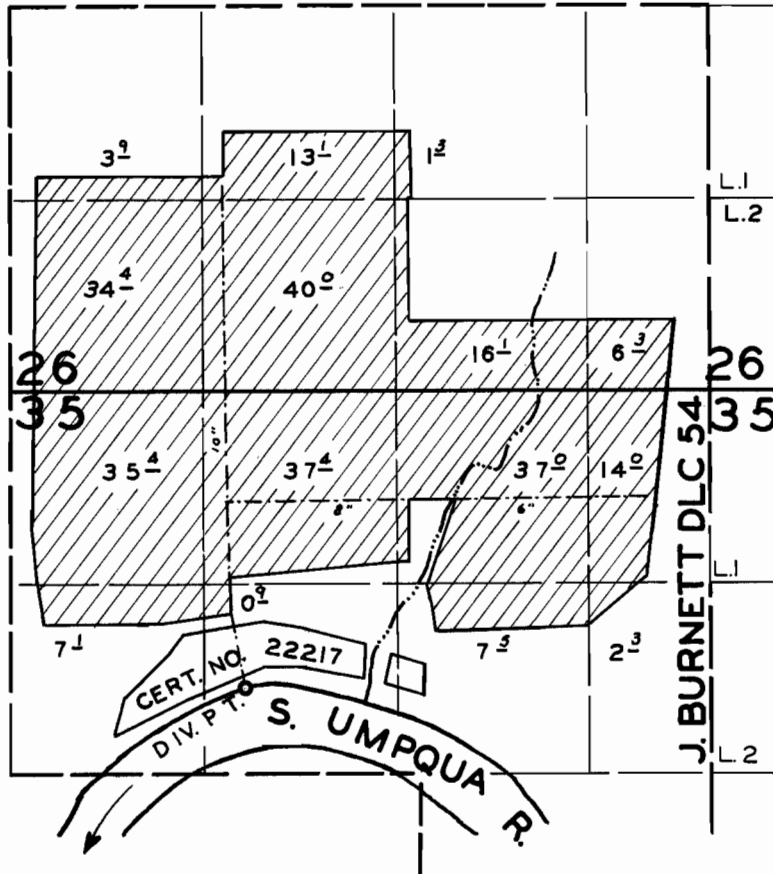

FINAL PROOF SURVEY
UNDER

Application No. 29446 Permit No. 23486
IN NAME OF

J. IRA MCNUTT

Surveyed AUG. 30. 19. 60, by C.O. BARTELS.