


T.27S.R.7W.W.M.

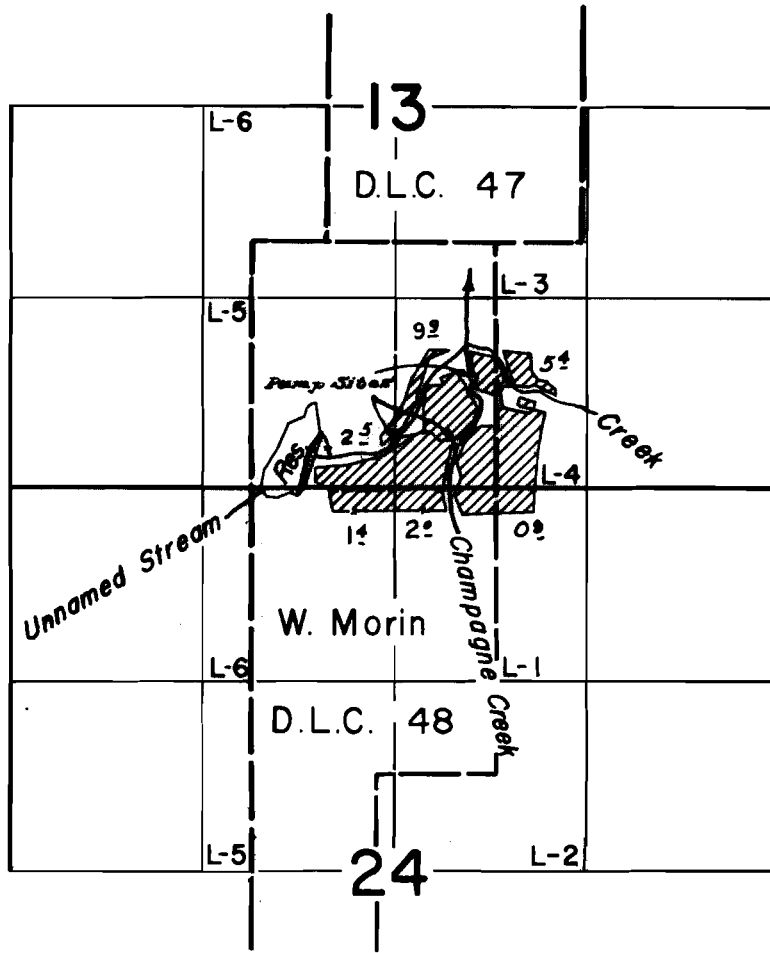

FINAL PROOF SURVEY
UNDER

R-30262 R-1755
Application No. 30263 Permit No. 23649
IN NAME OF

W. E. McComas

Surveyed June 27, 1960, by *R. Jackson*