


T. 26 S. R. 4 W. W. M.

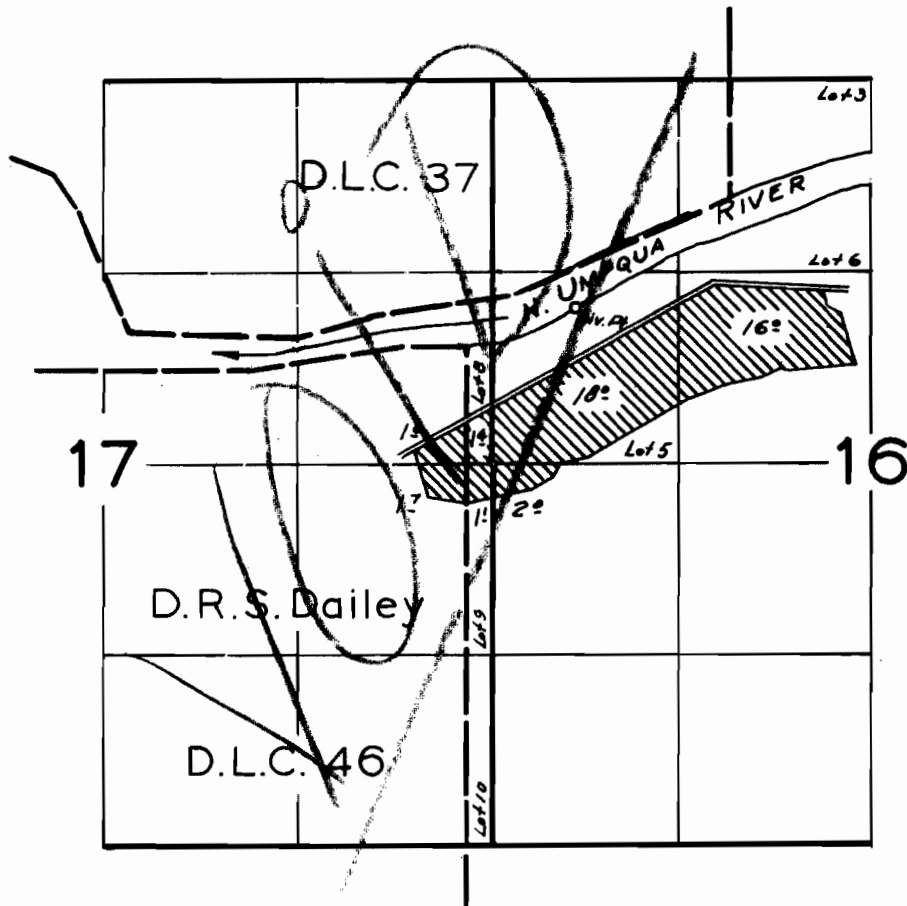


**FINAL PROOF SURVEY**  
UNDER

Application No. 31153..... Permit No. 24551.....  
IN NAME OF

*NYE & ALLENBY*

Surveyed June 23 1959, by *R. Jackson*

T. 26S. R. 4W. W.M.

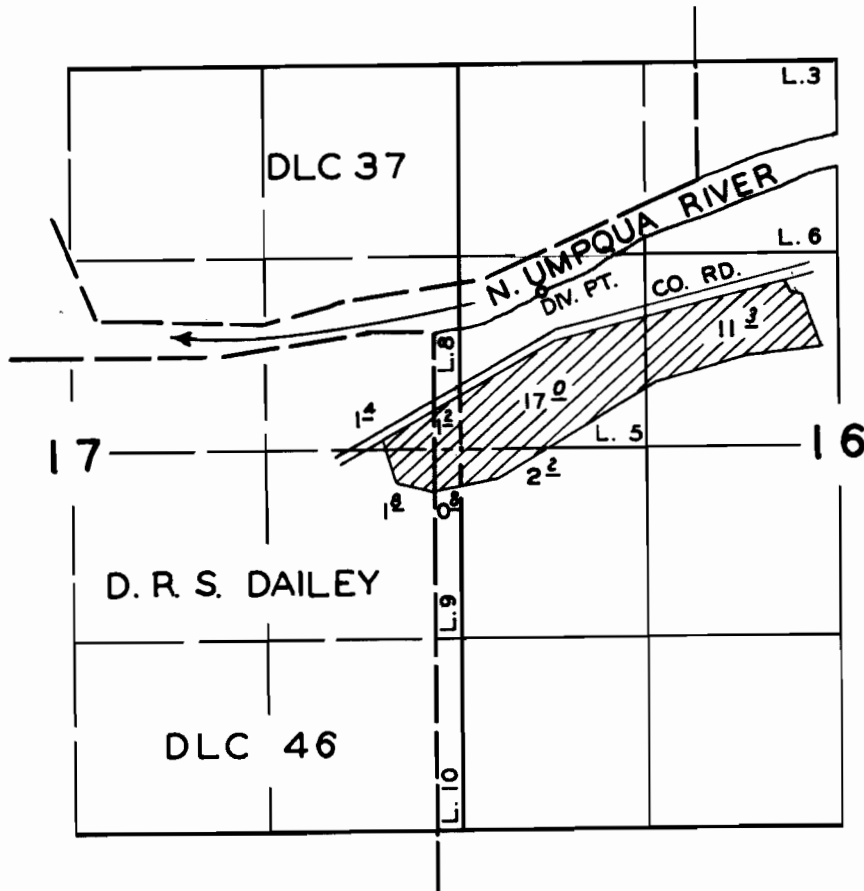

**FINAL PROOF SURVEY**  
UNDER

Application No. 31153 Permit No. 24551  
IN NAME OF

**NYE & ALLENBY**

Surveyed JUNE 23 59 R. H. JACKSON  
AUG. 26 1960, by C. O. BARTELS