

T. 26S. R. 6W. W.M.




**FINAL PROOF SURVEY**  
UNDER

Application No. 31487 Permit No. 24822  
IN NAME OF


M. O. KNAPP

Surveyed AUG. 24. 19.60. by G. O. BARTELS.

# T. 26 S., R. 6 W., W.M.

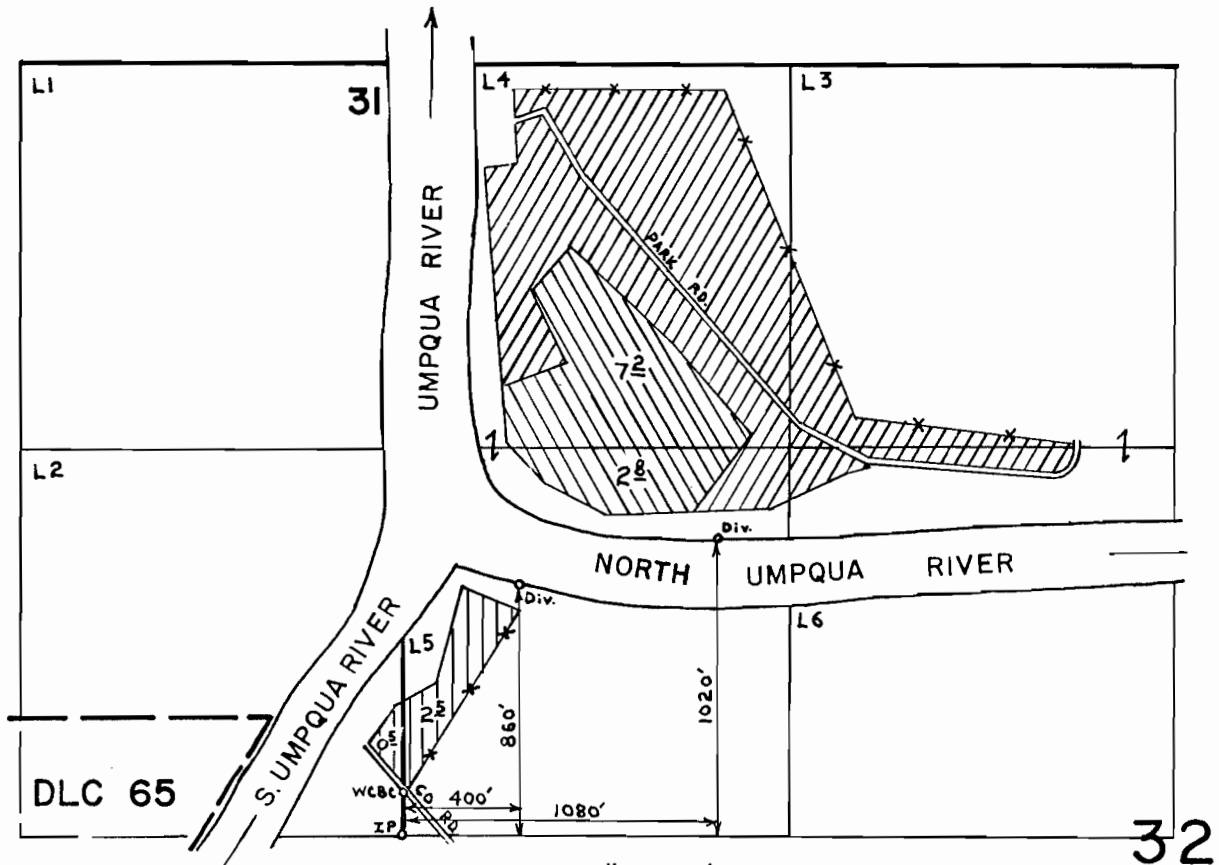

SCALE: 1" = 660'

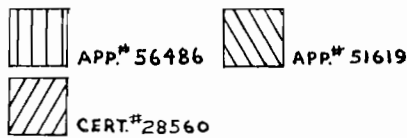

## FINAL PROOF SURVEY UNDER

Application No. 56486      Permit No. 42443  
51619      38932  
 IN NAME OF

DOUGLAS COUNTY PARKS DEPARTMENT

APR 25  
 Surveyed MAY 2, 1978, by D.W. SPARKS.....