T. 36 S. R. 2 E. W. M.

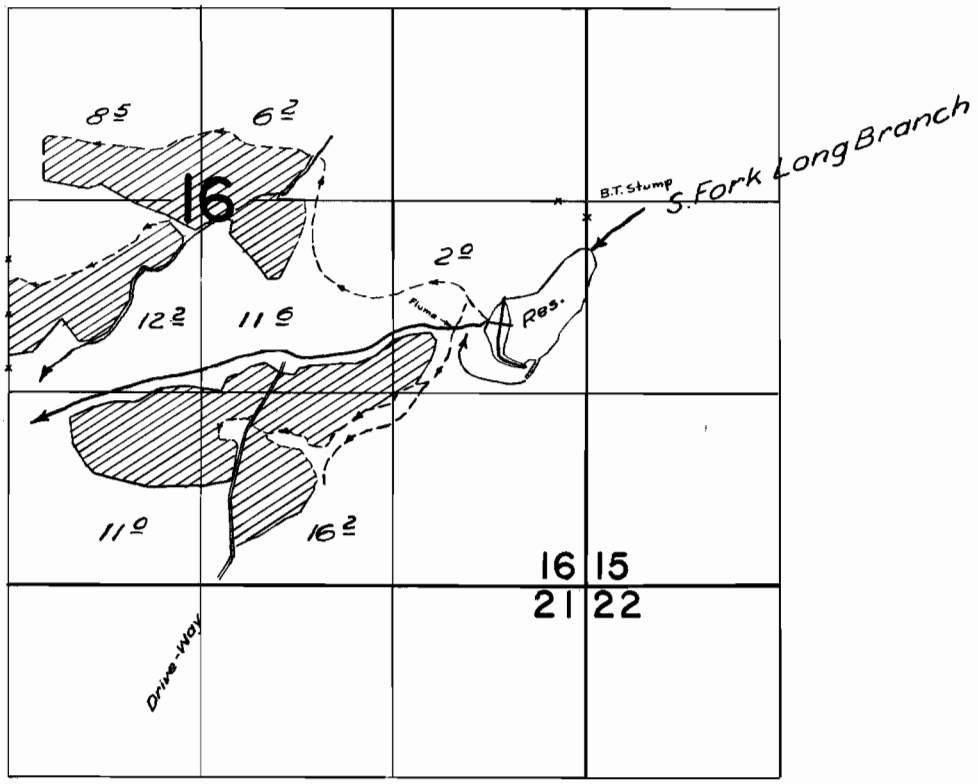

FINAL PROOF SURVEY
UNDER

Application No. R-25224 25225 Permit No. R-1078 19823

IN NAME OF

RAPHAEL GARDENER

Surveyed 13 APRIL 1960, by M. Bish

1960-B