


T.36S.R.2E.W.M.

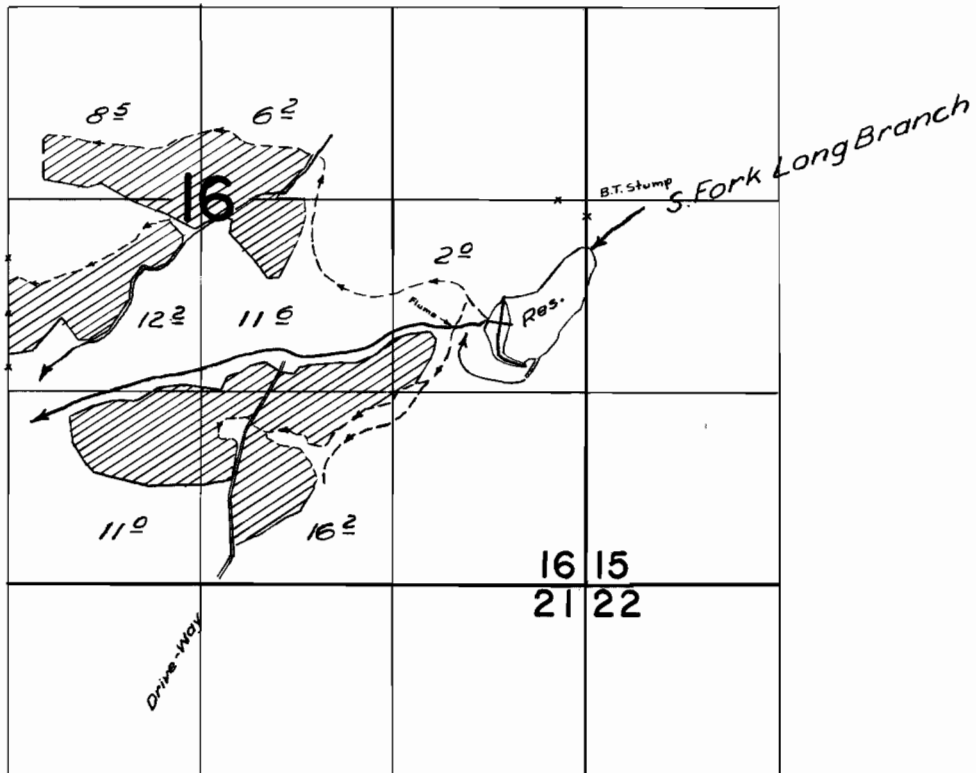

FINAL PROOF SURVEY UNDER

Application No. R-25224 Permit No. R-1078
25225 19823
IN NAME OF

RAPHAEL GARDENER

Surveyed 13 APRIL 1960, by M. Bish