


T. 39 S. R. 8 W. W.M.

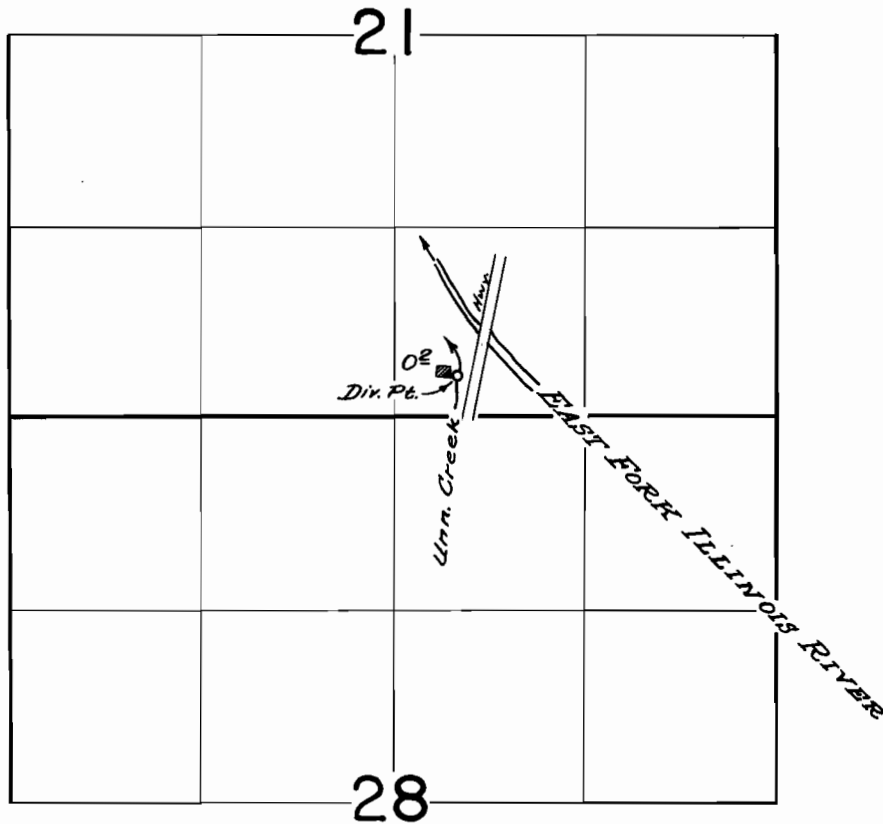

**FINAL PROOF SURVEY**  
UNDER

Application No. 23328... Permit No. 18393.....  
IN NAME OF

.....CARL D. FRERICHS.....

Surveyed Oct. 3..... 1960., by R. Steimer.....