


T.39S.R.8W.W.M.

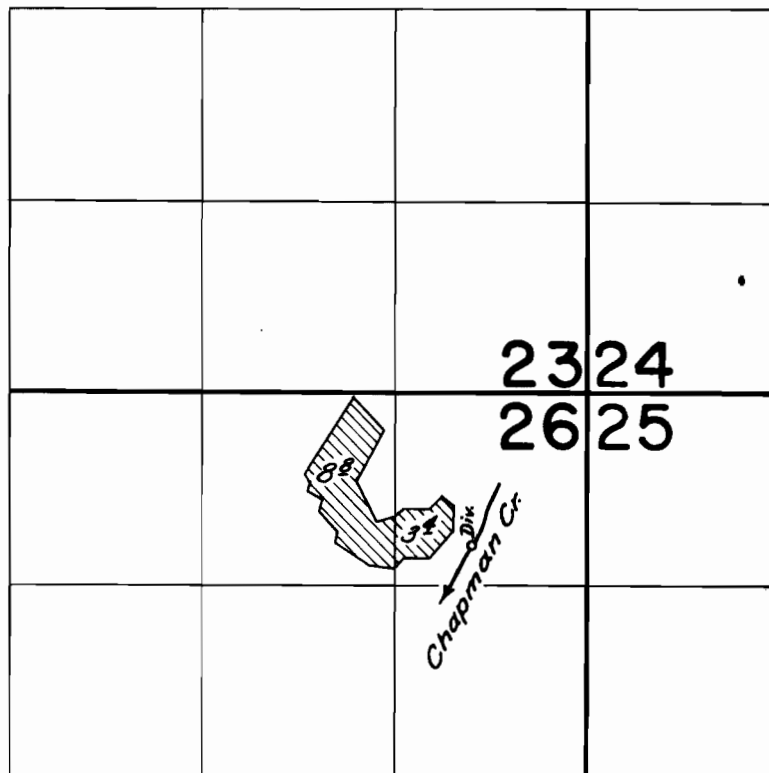

FINAL PROOF SURVEY
UNDER

Application No. 31934 Permit No. 25205
IN NAME OF

Roy M. Waldron

Surveyed Oct. 3, 1960, by R. Steimer