


# T.39 S.R.9 E.W.M.

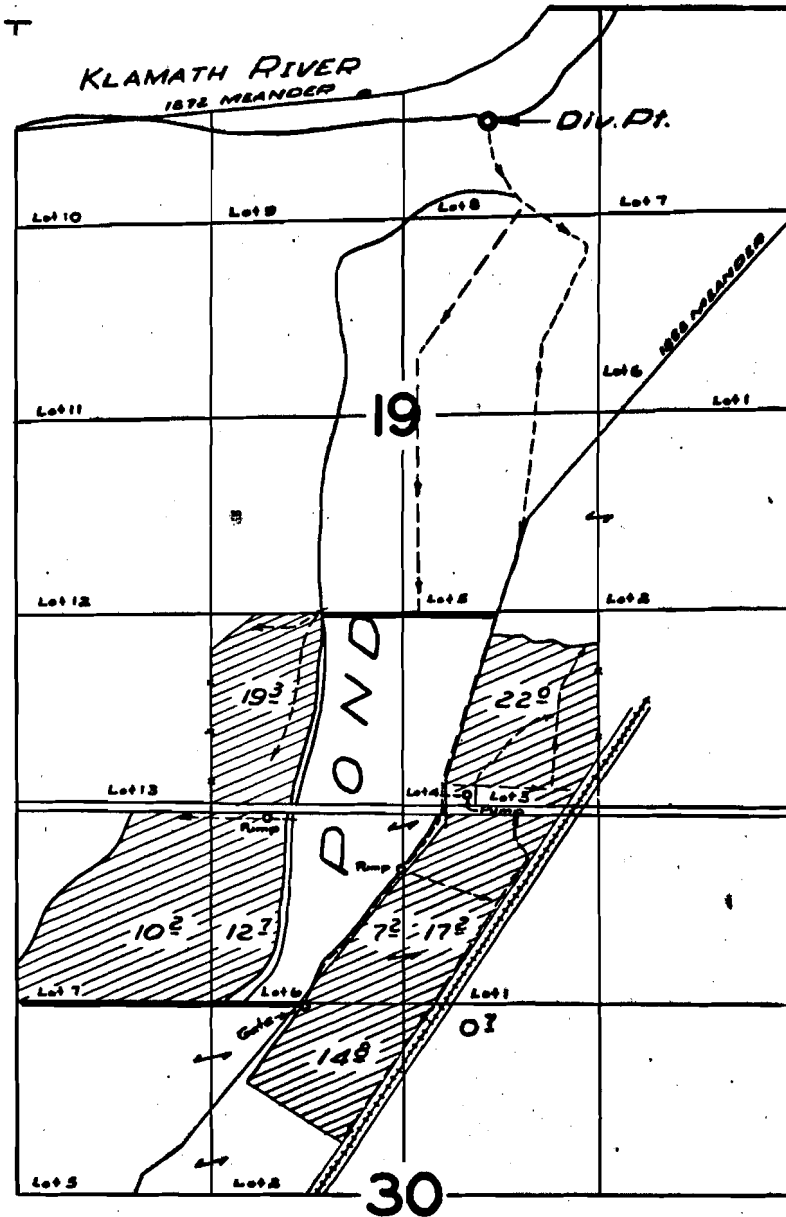

Klamath River

## FINAL PROOF SURVEY

UNDER

Application No. 25995 Permit No. 20367

IN NAME OF

OREGON STATE GAME COMMISSION

Surveyed 28 Oct. 1959, by m. B. B.