


U-665

28570  
28571

# T.26S. R.15E. W.M.

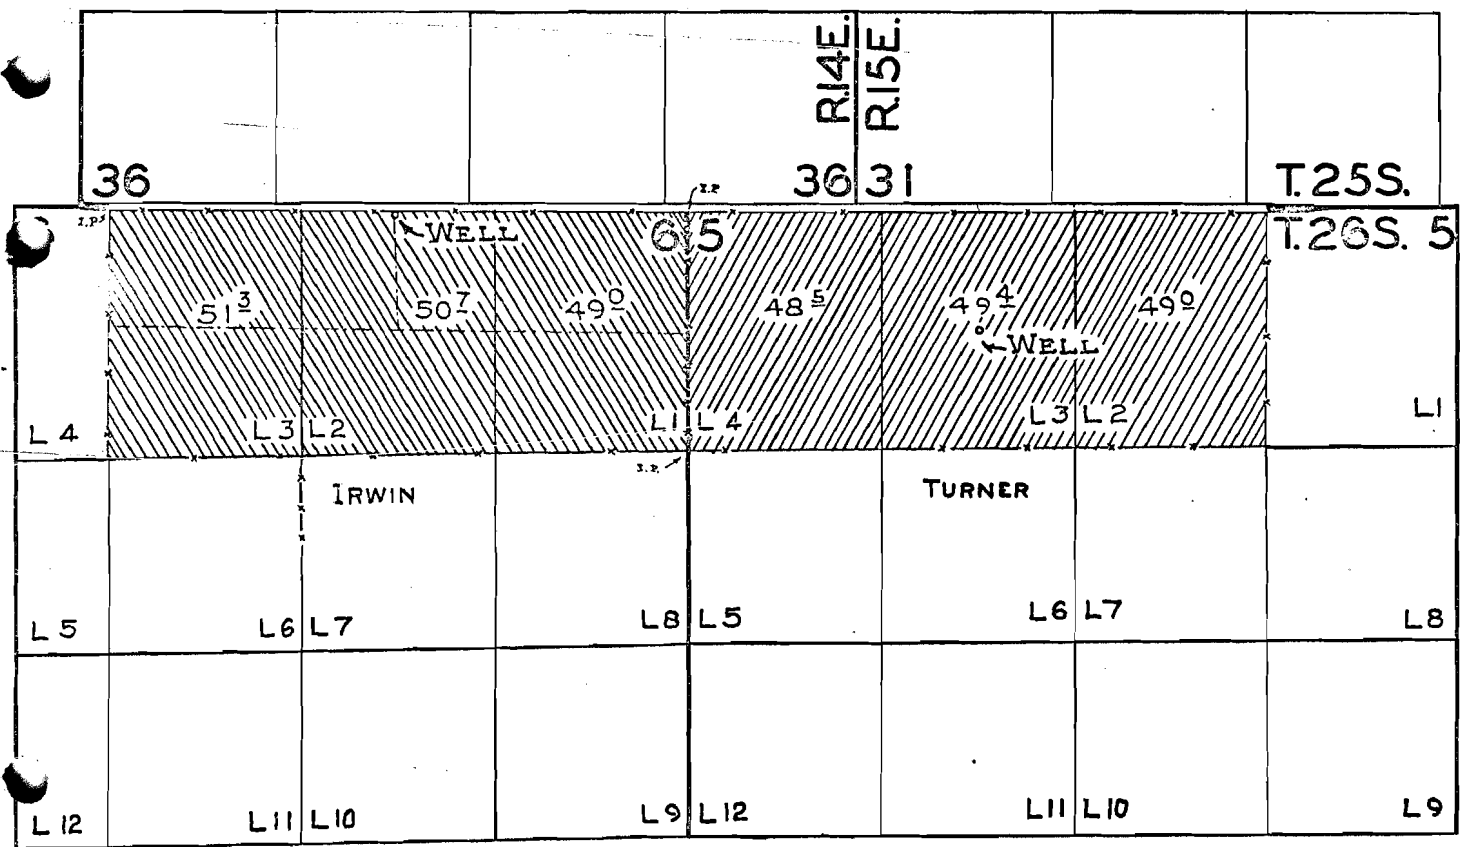

## FINAL PROOF SURVEY UNDER

Application No. U.74.3. Permit No. U.665....  
 IN NAME OF  
**ED & VERNA TURNER**  
**ECHO & GLENN IRWIN**  
 Surveyed MAY.12 1959, by M. BISH.....

1959-C

*M.B.*