


76-665

28570
28571

T.26S. R.15E.W.M.

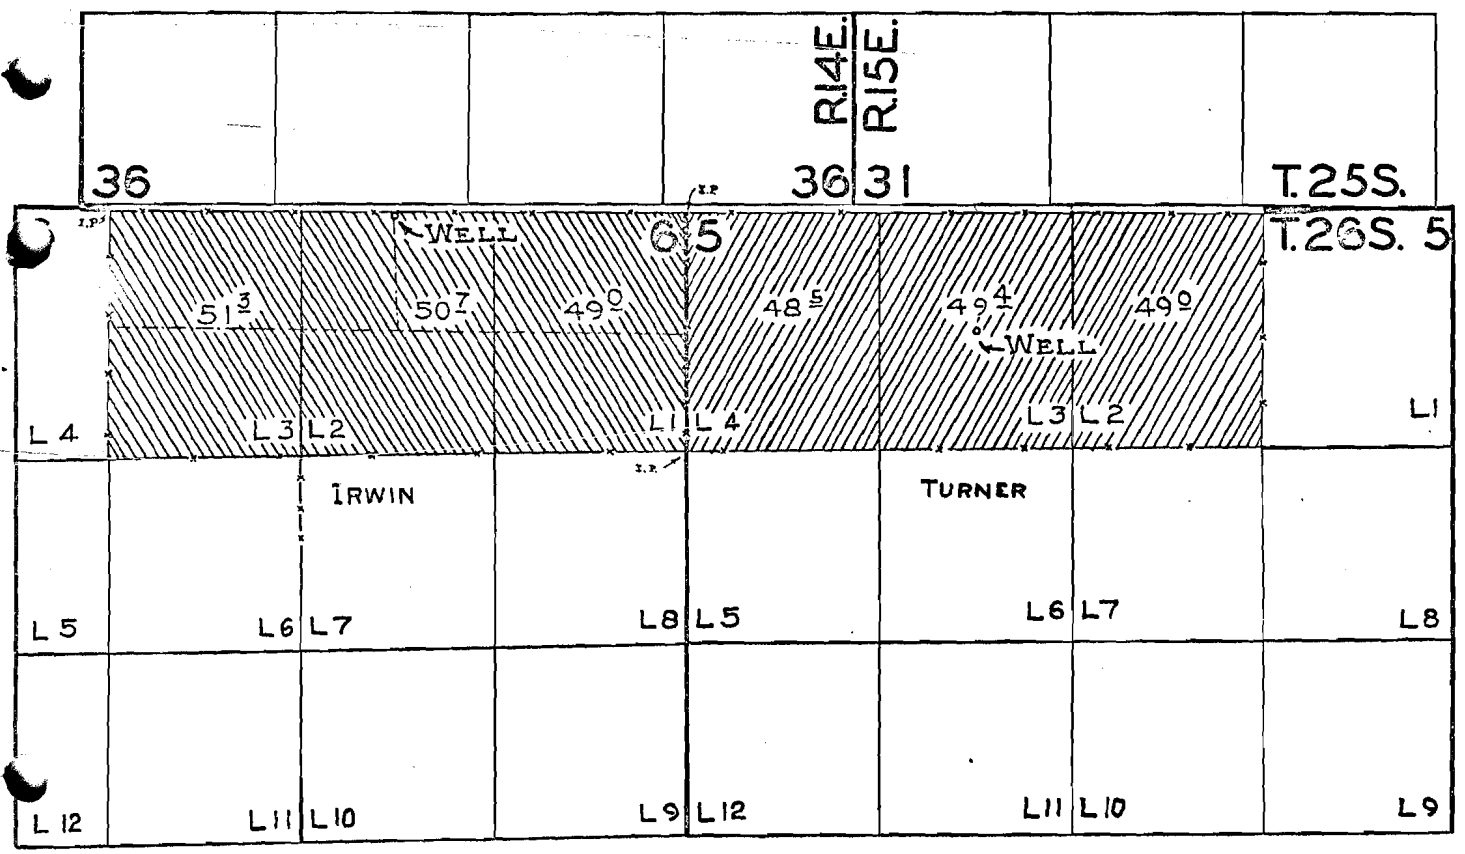

FINAL PROOF SURVEY UNDER

Application No. U.74.3 Permit No. U.665....
 IN NAME OF
ED & VERNA TURNER
ECHO & GLENN IRWIN
 Surveyed MAY.12 1959, by M. BISH.....