


T.19S.R.3W.W.M.

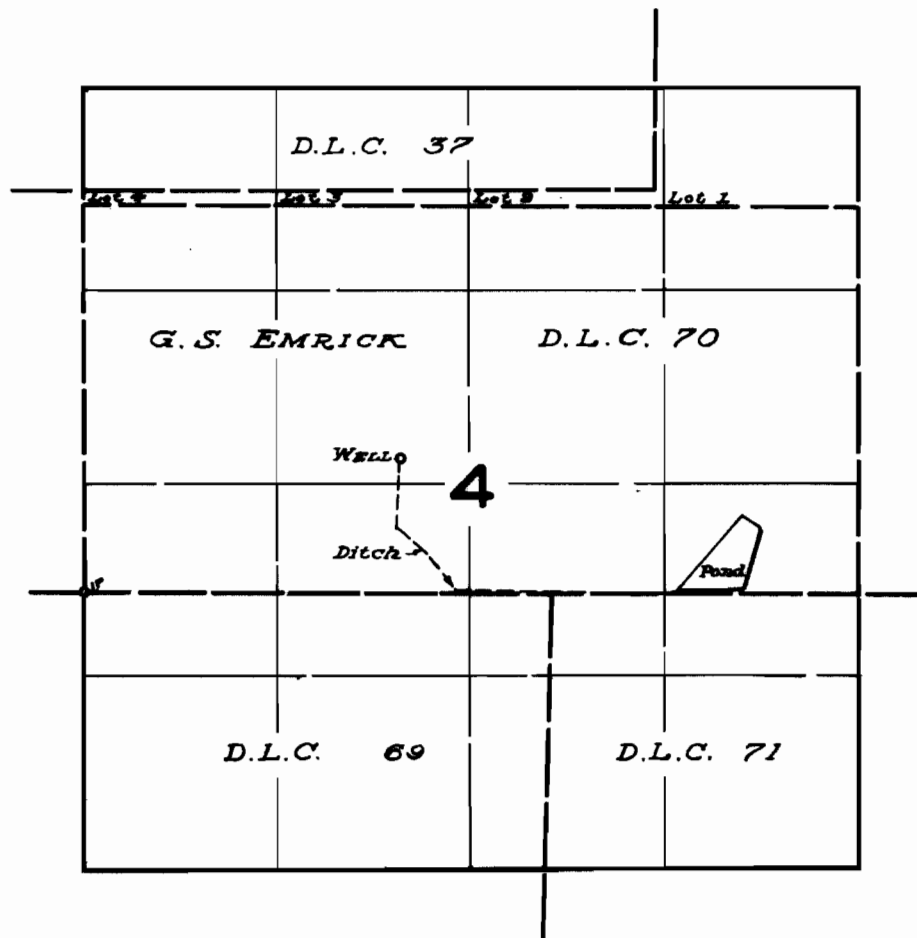

FINAL PROOF SURVEY
UNDER

Application No. G-479 Permit No. G-339
IN NAME OF

OREGON STATE GAME COMMISSION

Surveyed MAR. 30 1959, by M. BISH
MAY 6 60 R.H. JACKSON