


T.19S. R.3W. W.M.

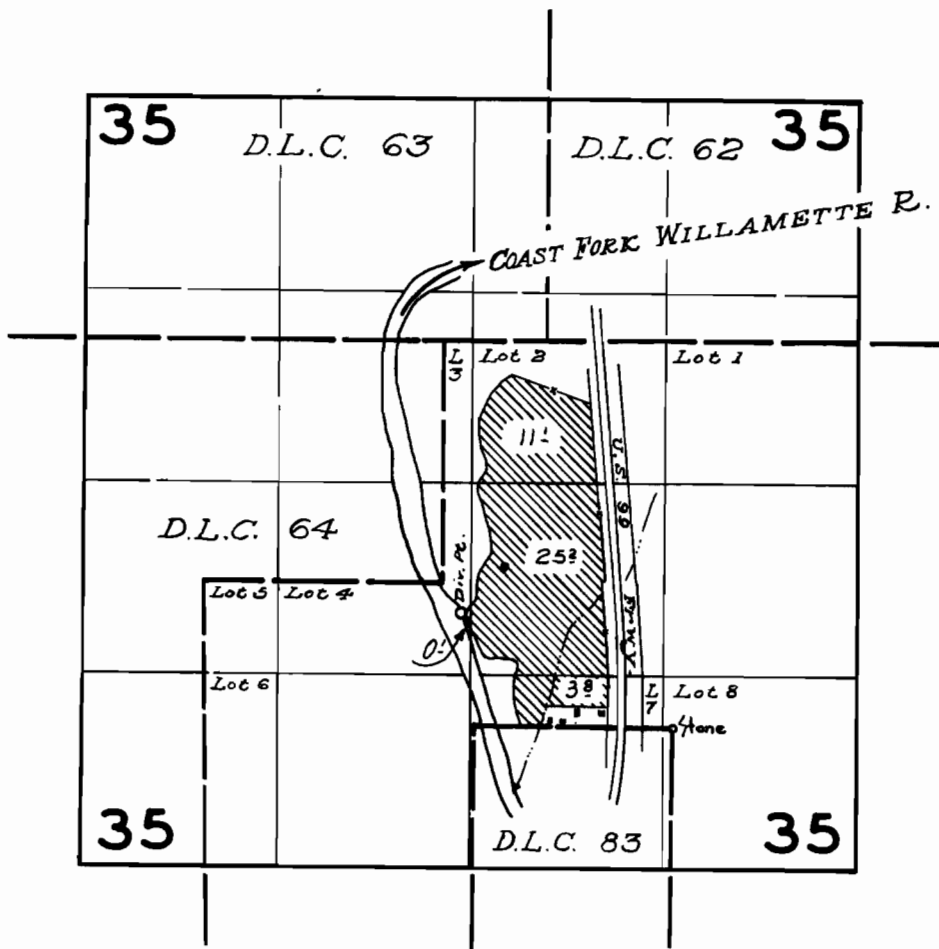

FINAL PROOF SURVEY UNDER

Application No. 30913 Permit No. 24335
IN NAME OF

Surveyed May 12, 1960, by *A. H. Johnson*