


T.16 S.R.1 W.W.M.

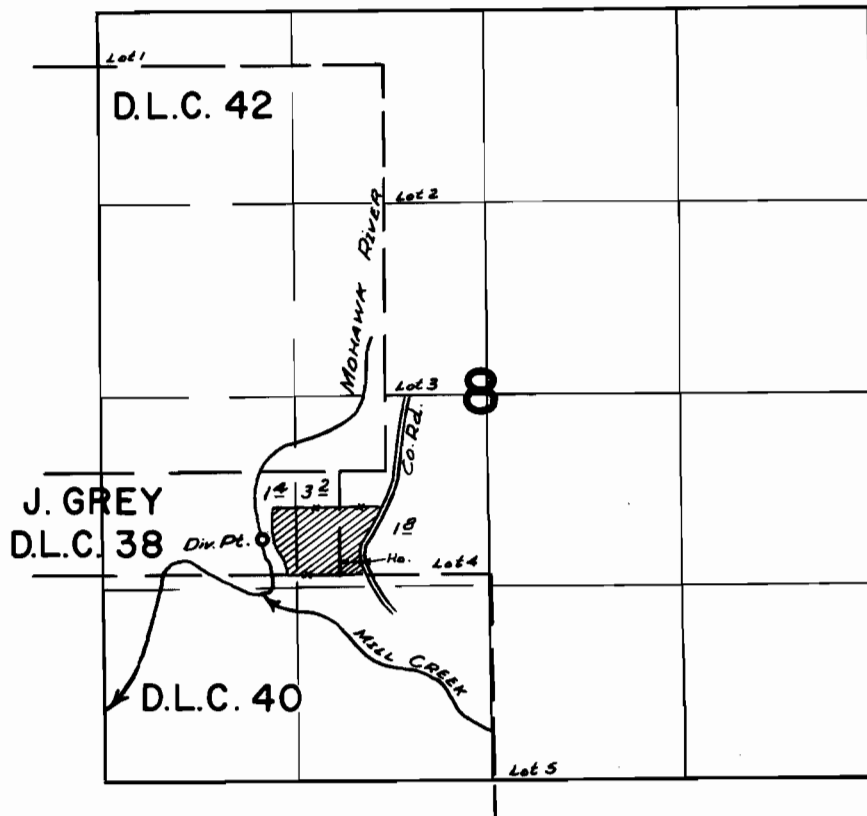

FINAL PROOF SURVEY
UNDER

Application No. 32063 Permit No. 25303
IN NAME OF

WILLIAM J. DALE

Surveyed 3 MAR 1960, by me Bish