


# T. 19 S. R. 1 E. W. M.

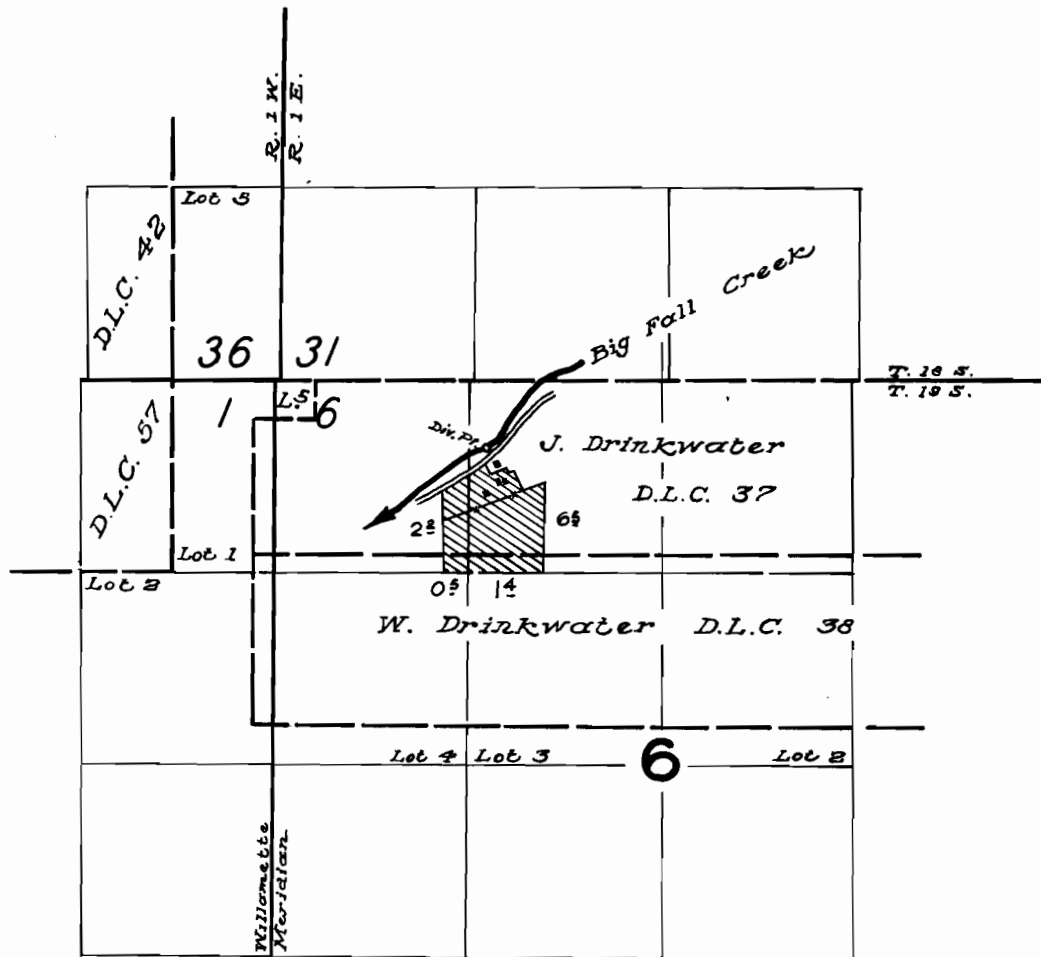

## FINAL PROOF SURVEY UNDER

Application No. 32471. Permit No. 25639  
IN NAME OF

**HARRY W. WENICK**

Surveyed May 10, 1960, by *R. Jackson*