


T.11S.R.8W.W.M.

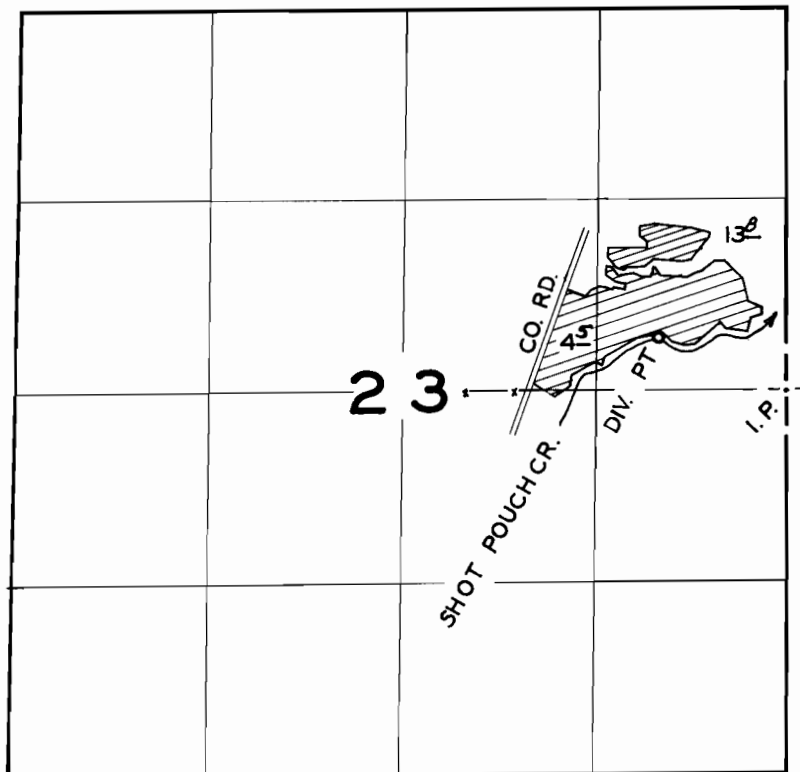

FINAL PROOF SURVEY
UNDER

Application No. 26620..... Permit No. 20845.....
IN NAME OF

P. N. DOWNING

Surveyed AUG. 17 1960, by R. H. JACKSON