


T.11S.R.8.W.W.M.

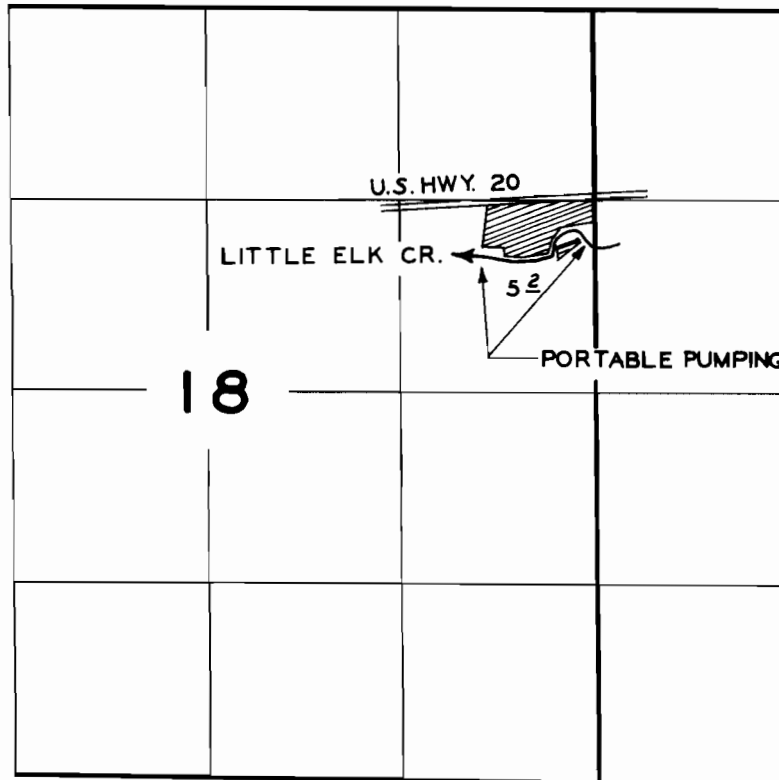

FINAL PROOF SURVEY
UNDER

Application No. 28432 Permit No. 22466
IN NAME OF

GUY G. PALMER

Surveyed AUG. 18 1960, by R. H. JACKSON