


T.II S.R.IOW.W.M.

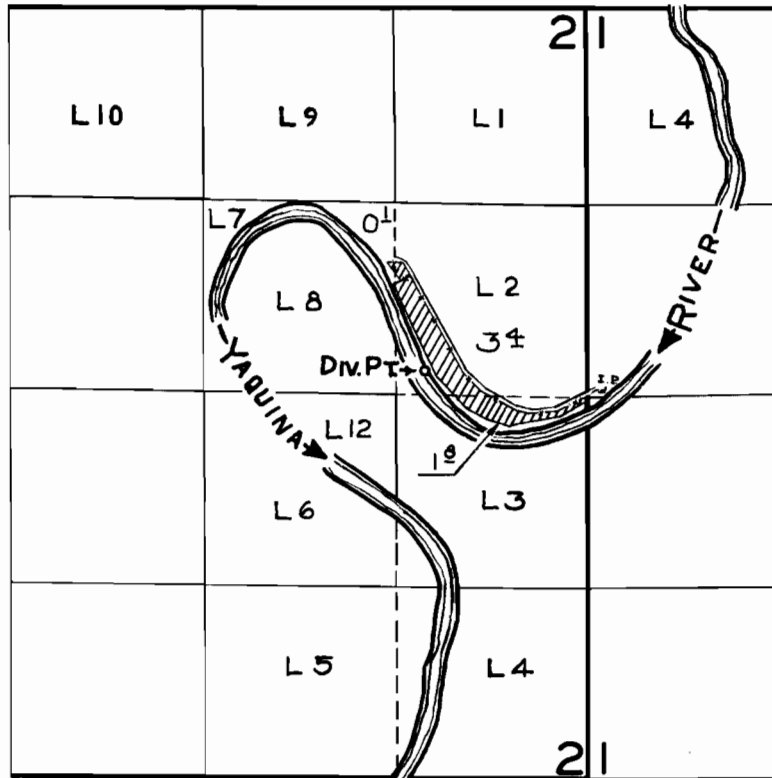

FINAL PROOF SURVEY
UNDER

Application No. 29966 Permit No. 23607
IN NAME OF

CARL S. McCLAFLIN

Surveyed Aug. 19, 1960, by M. BISH