


T.11S.R.8W.W.M.

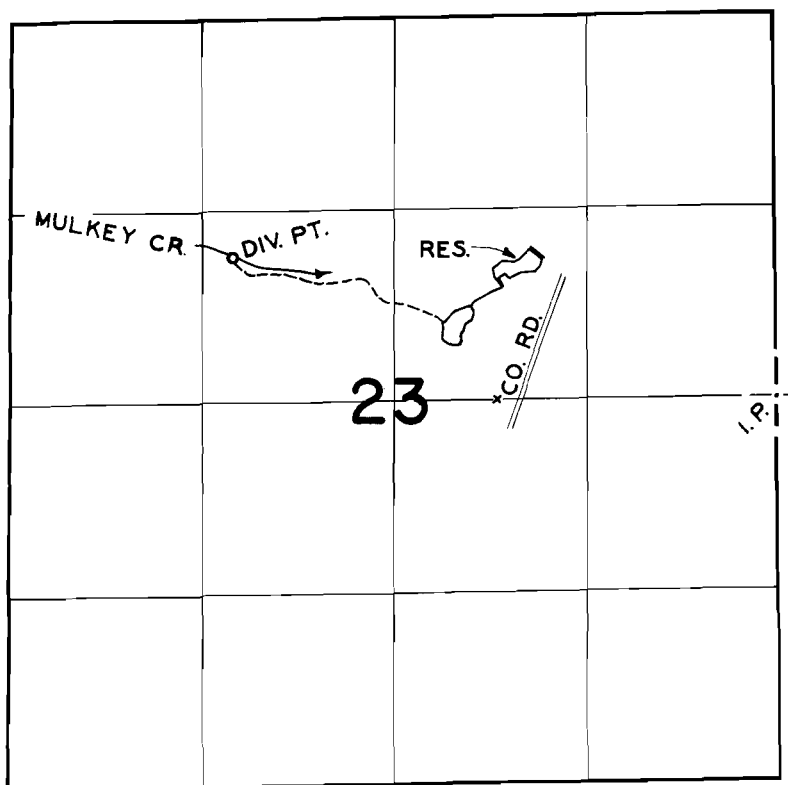

FINAL PROOF SURVEY
UNDER

Application No. R30872
31033 Permit No. R1939
24509
IN NAME OF

V.E. Plunkett

Surveyed AUG. 17, 1960, by R. H. JACKSON