


T.I.S.R.I.W.W.M.

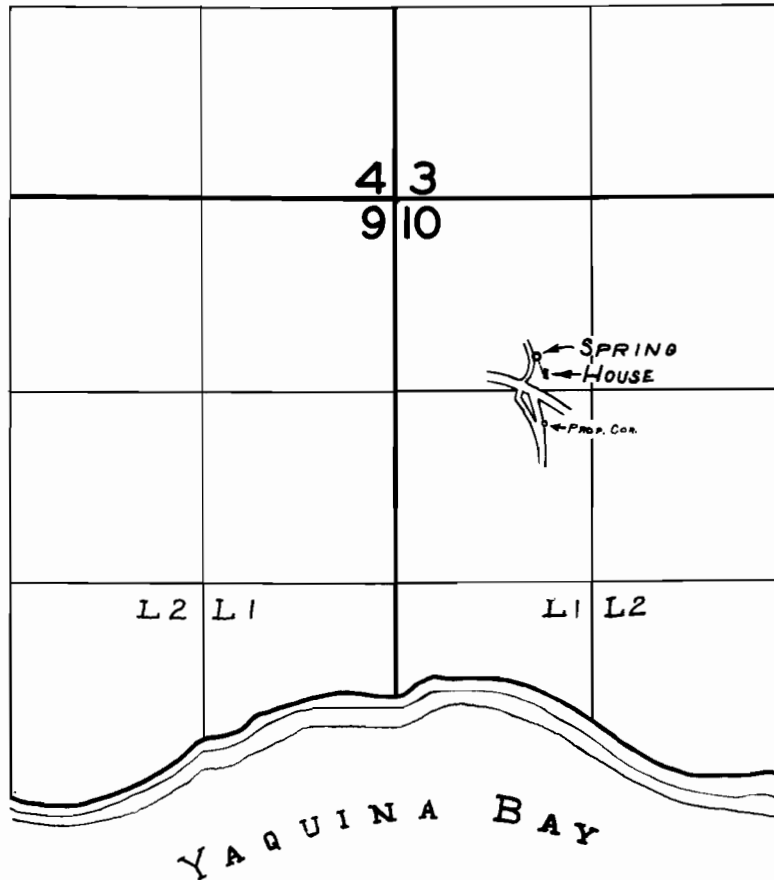

FINAL PROOF SURVEY
UNDER

Application No. 31127..... Permit No. 24519.....
IN NAME OF

.....A. J. BECKER.....

Surveyed AUG. 17 1960, by M. BLISH.....

1960-E

114