


T. 12 S. R. 4 W. W. M.

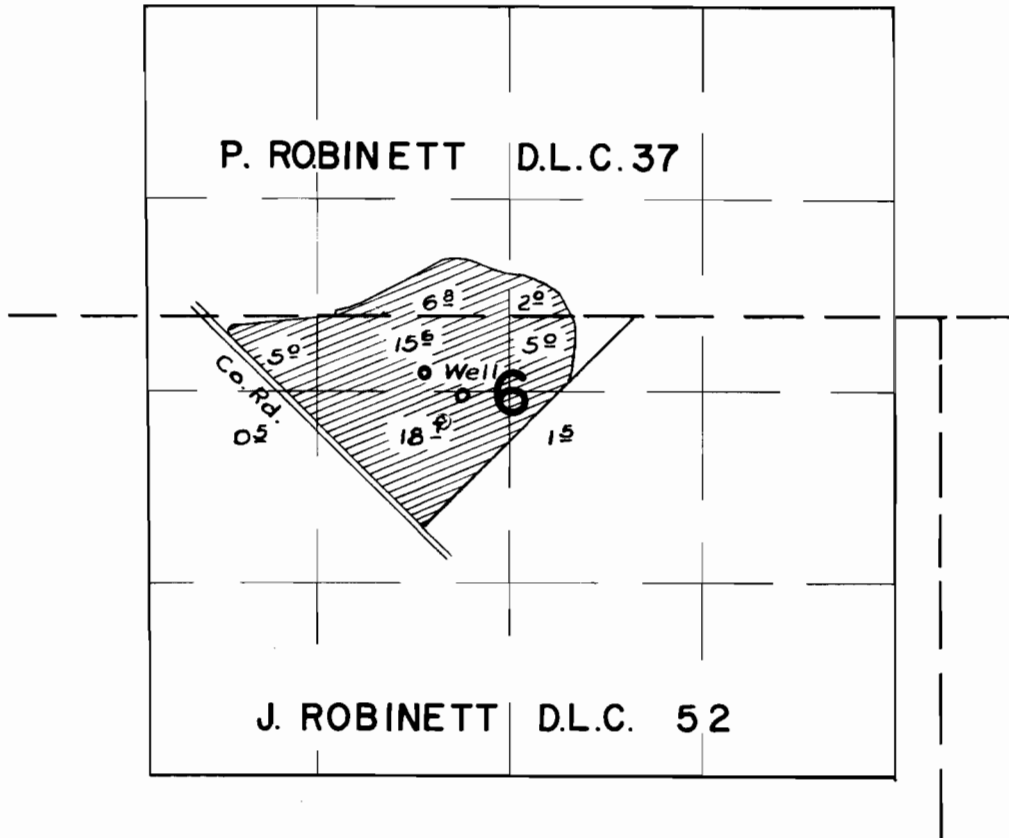

**FINAL PROOF SURVEY**  
UNDER

Application No. G-560... Permit No. G-472...  
IN NAME OF

..... MRS. ZACK TAYLOR .....

Surveyed 3 Aug. 1960, by *m. Bish* .....