


# T.10S.R.3W.W.M.

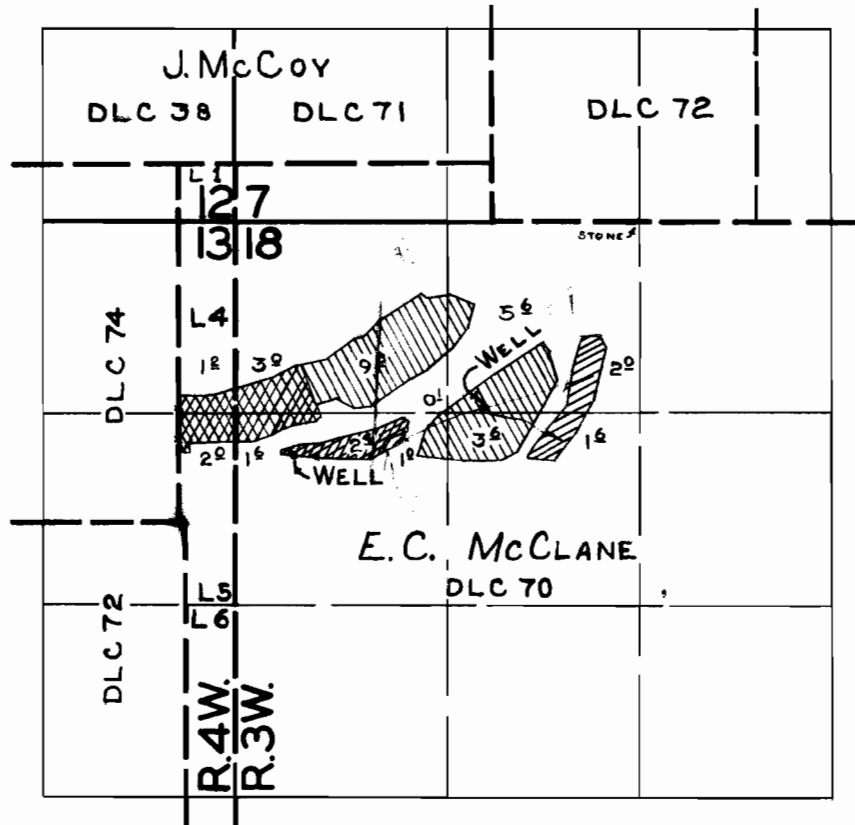

## FINAL PROOF SURVEY UNDER

G-143                      G-42  
 G-722                      G-639  
 Application No. G-1289    Permit No. G-1133  
 IN NAME OF



..... GEORGE E. & DOROTHY M. WEBER .....

Surveyed JUNE 22:23 1960, by M. BISH.....