


T. 10S. R. 1E. W. 4M.

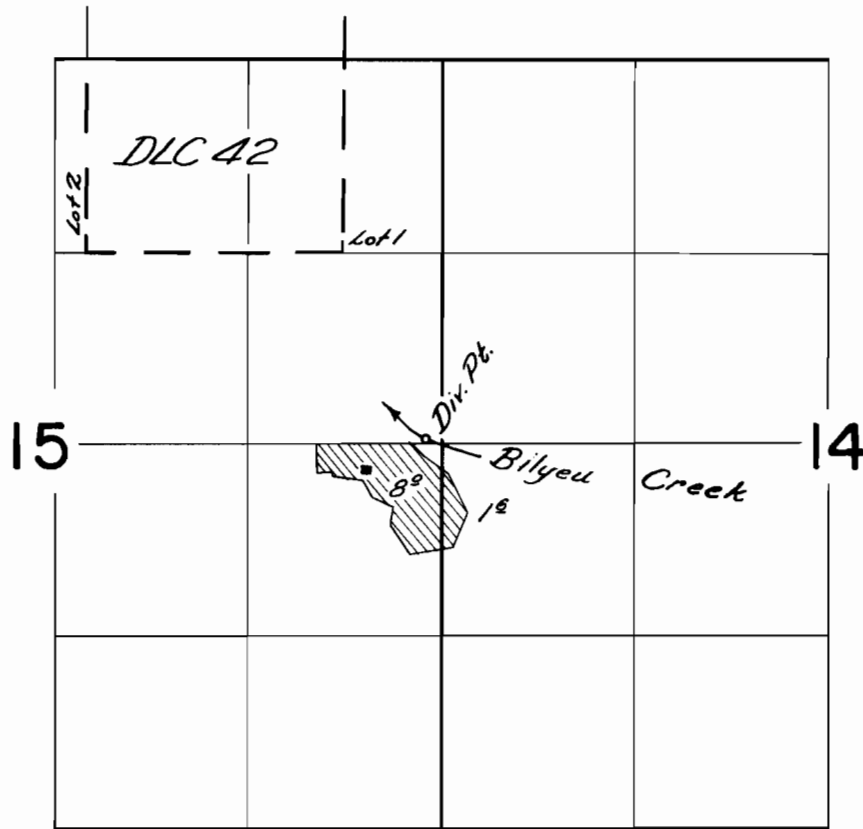

FINAL PROOF SURVEY UNDER

Application No. 28119 Permit No. 22430
IN NAME OF

HENRY J. & FRANCIS W. RIESTER

Surveyed AUG. 19, 1960, by C. O. Baetels

M

1960-W