


T.18S. R.47E.W.M.

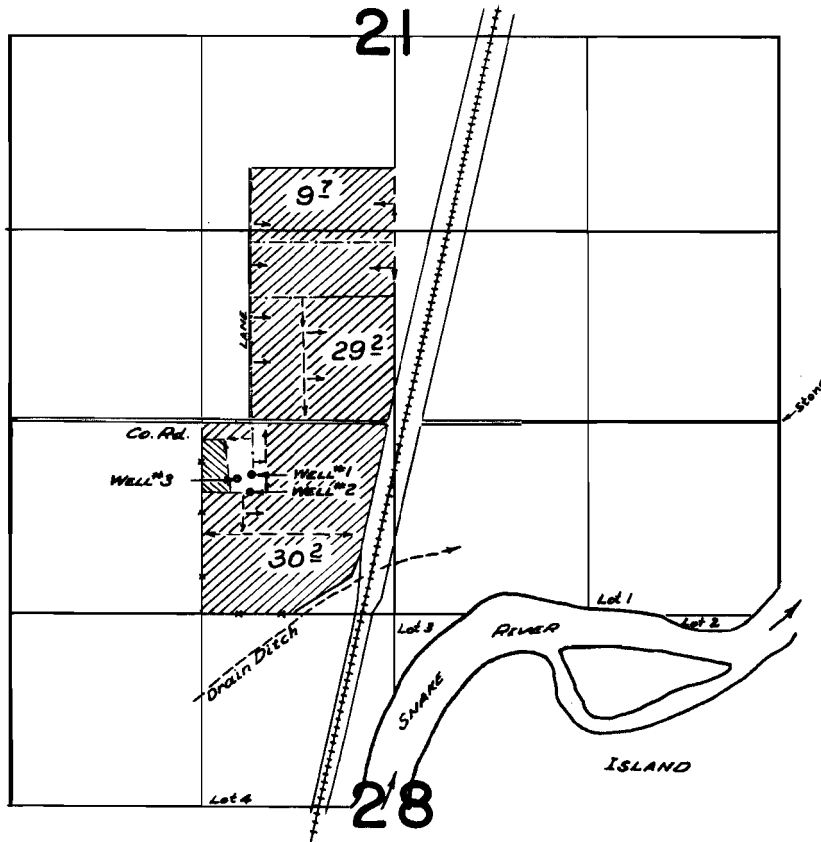

FINAL PROOF SURVEY
UNDER

Application No. G-95 Permit No. G-72
IN NAME OF

CLIFFORD NIELSEN

Surveyed 27 Oct. 1960, by M. Bish