


T.18S.R.47E.W.M.

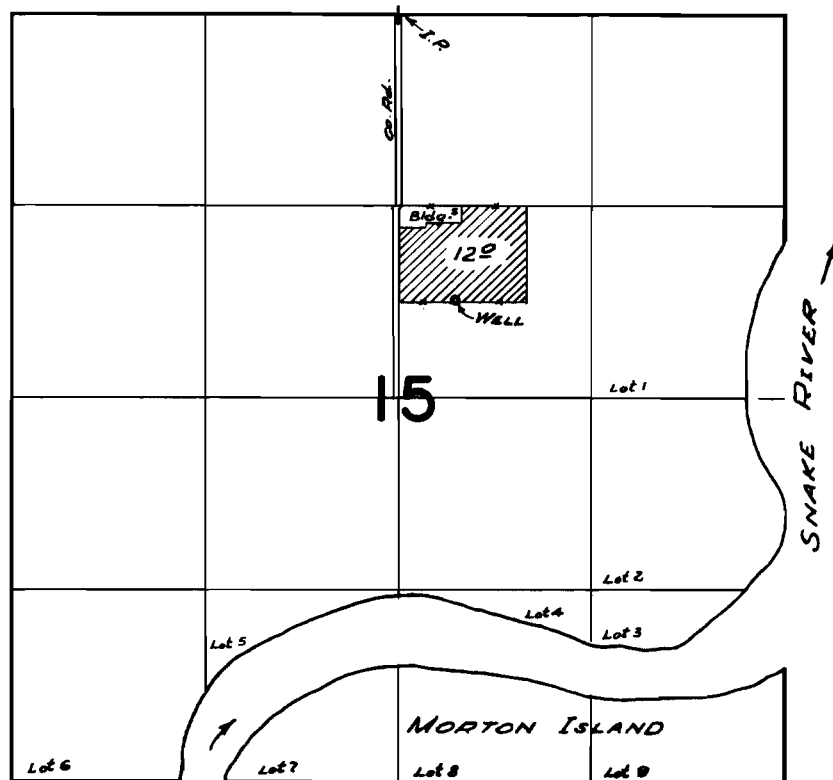

FINAL PROOF SURVEY
UNDER

Application No. G-405 Permit No. G-329
IN NAME OF

JOHN T. DONOVAN

Surveyed 27 Oct. 1960, by me Besh