


T. 5S. R. 1W. W.M.

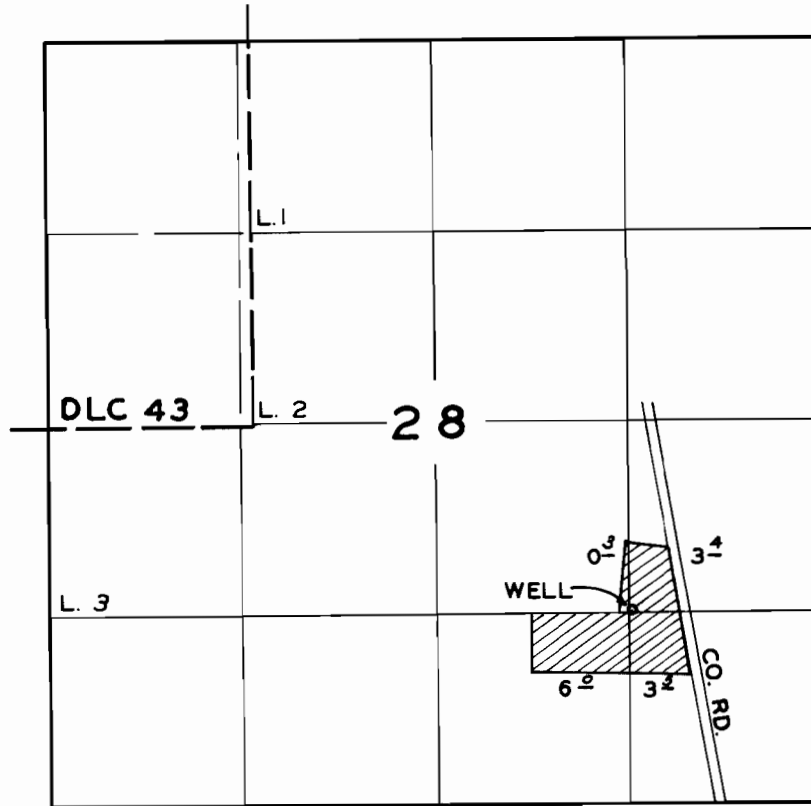

FINAL PROOF SURVEY
UNDER

Application No. 6 348 Permit No. 6 227
IN NAME OF

E. S. Minton

Surveyed SEPT. 7, 1960, by C. O. BARTELS