


T.6S.R.3W.W.M.

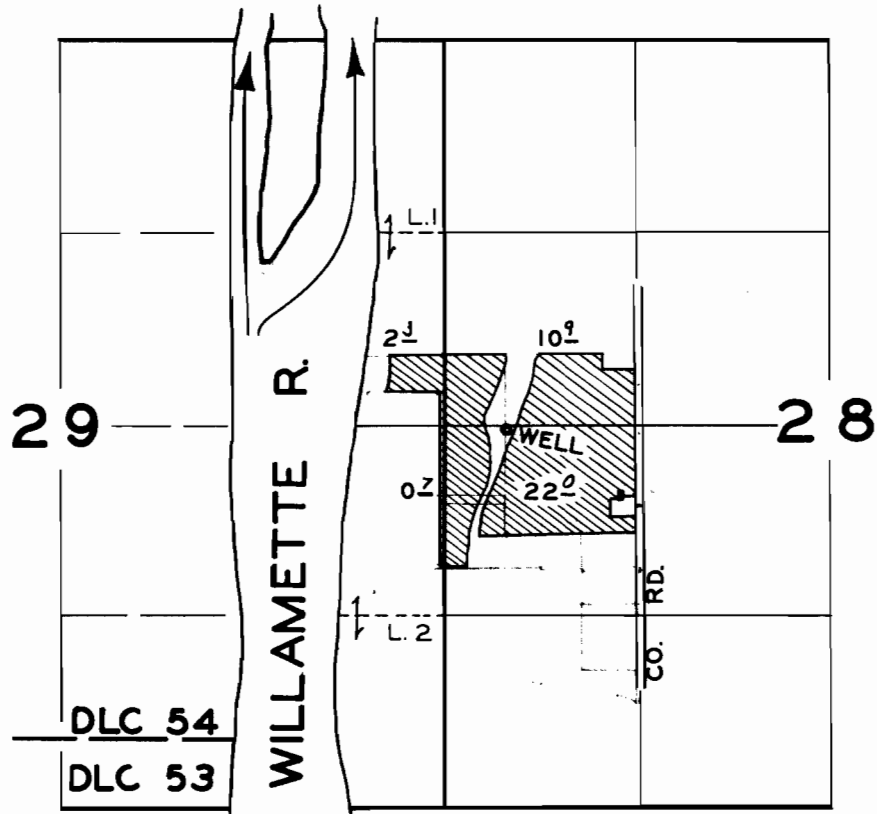

FINAL PROOF SURVEY
UNDER

Application No. G650 Permit No. G.544
IN NAME OF

B. E. STRATTON

Surveyed NOV. 9 1960, by R. H. JACKSON.